

SURVEY & REMONUMENTATION

MAY 03 1995

**CHEBOYGAN COUNTY REMONUMENTATION CORNER
LAND CORNER RECORDATION CERTIFICATE
Filing Requirement of Act 74, Mich. P.A. 1970**

DEC 29 1994

For corners in

COMMISSION

RECEIVED FOR RECORD
at 12:48 O'Clock P M

Cheboygan
(County)

Located In:

Corner Code #

1. Public Land Survey	T <u>35N</u> R <u>1W</u>	<u>A-3</u>
	T _____ R _____	_____
	T _____ R _____	_____
	T _____ R _____	_____
2. Property Controlling in Section	S _____ T _____ R _____	_____
	S _____ T _____ R _____	_____
3. Miscellaneous Property in Sec.	S _____ T _____ R _____	_____
	S _____ T _____ R _____	_____

Jeanne Spray

CLERK/REGISTER
CHEBOYGAN COUNTY, MICHIGAN

Register of Deeds Stamp & File Number

4. Lot No. _____, Recorded Plat _____
5. Private Claims _____

	A	B	C	D	E	F	G	H	I	J	K	L	M
2	6	5	4	3	2	1							
3													
4	7	8	9	10	11	12							
5													
6	18	17	16	15	14	13							
7													
8	19	20	21	22	23	24							
9													
10	30	29	28	27	26	25							
11													
12	31	32	33	34	35	36							
13													

I, Richard C. Dunn, in a field survey on October, 19 94, do hereby certify that under requirements of P.A. 74, Michigan P.A. of 1970, the corner points mentioned in lines 1 and 2 above were in conformance with regulations and rules therefore as required in the current manual of survey instructions of the United States Department of the Interior, Bureau of Land Management or by a decree of a Court of Law and/or that the corner points mentioned in lines 3, 4 and 5 above were in conformance with the rules of the Michigan Board of Land Surveyors or by a Decree of a Court of Law; established, re-established, monumented, re-monumented, recovered, found as expressed below:

NOTE: Not more than 4 corners, all in the same town and range, may be recorded on this certificate.

A. Description of original monument and accessories and/or subsequent restoration:


G.L.O. John Mullett 1840
Set Post
36" Pine S78°E 8 Links
20" Pine N76°W 36 Links

Dean Delameter #5778
Jan. 1962 Set 5/8" Iron Rod
Liber A, page 370
6" Oak S15°E 40.33'
4" Oak S53°W 56.64'
6" Oak N7°E 60.63'

B. Description of corner evidence found and/or method applied in restoring or reestablishing corner:

Found 5/8" Iron Rod per Dean Delameter survey dated January, 1962 as recorded in Liber A, page 370.

Marcus A. Ross

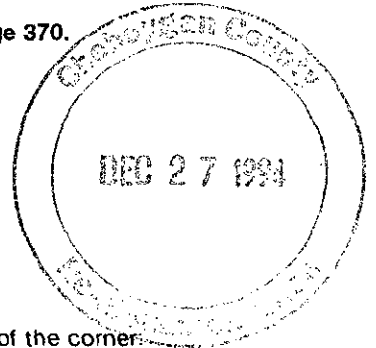

C. Description of monument for corner and accessories established to perpetuate locating the position of the corner:

A-3 Found 5/8" Iron Rod, replaced with 5/8" x 30" Iron Bar and 3" aluminum cap Per Liber A, page 370, Cheboygan County Records and is accepted as a careful and faithful reestablishment of the position of the original corner
21" Oak S15°E 40.33'
18" Oak S53°W 56.64'
20" Oak N7°E 60.63'
6" Maple N26°W 57.85'

LIBER 010 PAGE 96



igned by Richard C. Dunn

Date December 15, 1994

urveyor's Michigan License No. 12020