

**SURVEY &
REMONUMENTATION** CHEBOYGAN COUNTY REMONUMENTATION CORNER

KC
MAY 03 1995

LAND CORNER RECORDATION CERTIFICATE
Filing Requirement of Act 74, Mich. P.A. 1970

DEC 29 1994

For corners in
Cheboygan
(County)

COMMISSION

Located In:

Corner Code #

RECEIVED FOR RECORD
at 12:50 O'Clock P M

James Gray

CLERK/REGISTER
CHEBOYGAN COUNTY, MICHIGAN

Register of Deeds Stamp & File Number

- | | | | | | |
|------------------------------------|---|------------|---|-----------|------------|
| 1. Public Land Survey | T | <u>35N</u> | R | <u>1W</u> | <u>A-6</u> |
| | T | | R | | |
| | T | | R | | |
| | T | | R | | |
| 2. Property Controlling in Section | S | | T | R | |
| | S | | T | R | |
| 3. Miscellaneous Property in Sec. | S | | T | R | |
| | S | | T | R | |

4. Lot No. _____, Recorded Plat _____
5. Private Claims _____

	A	B	C	D	E	F	G	H	I	J	K	L	M
2	6	5	4	3	2	1							
3													
4	7	8	9	10	11	12							
5													
6	18	17	16	15	14	13							
7													
8	19	20	21	22	23	24							
9													
10	30	29	28	27	26	25							
11													
12	31	32	33	34	35	36							
13													

I, Richard C. Dunn, in a field survey on October, 19 94, do hereby certify that under requirements of P.A. 74, Michigan P.A. of 1970, the corner points mentioned in lines 1 and 2 above were in conformance with regulations and rules therefore as required in the current manual of survey instructions of the United States Department of the Interior, Bureau of Land Management or by a decree of a Court of Law and/or that the corner points mentioned in lines 3, 4 and 5 above were in conformance with the rules of the Michigan Board of Land Surveyors or by a Decree of a Court of Law; established, re-established, monumented, re-monumented, recovered, found as expressed below:

NOTE: Not more than 4 corners, all in the same town and range, may be recorded on this certificate.


A. Description of original monument and accessories and/or subsequent restoration:

G.L.O. John Mullett 1840
Set Quarter Section Post
10" Beech S83°E 24 Links
8" Beech N69°W 25 Links

B. Description of corner evidence found and/or method applied in restoring or reestablishing corner:

Fnd. 1" Iron Pipe
Fnd. DNR witness tag in 8" Birch, N37°E 12.15'
Fnd. DNR witness tag in 24" Tri. Oak West 90.0'
Both witnesses dated 6-17-92 by T. Stone


Martin Ross

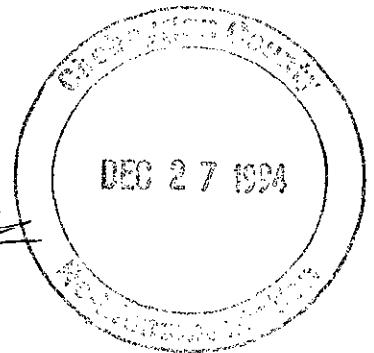

C. Description of monument for corner and accessories established to perpetuate locating the position of the corner:

A-6 Fnd. 1" Iron Pipe. Replaced with 5/8" x 30" aluminum cap and is accepted as a careful and faithful reestablishment of the position of the original corner.
8" Birch N37°E 12.15'
8" Beech S71°E 21.56'
14" Aspen N54°W 10.70'
18" Maple Clump S41°E 19.15'

LIBER 010 PAGE 100

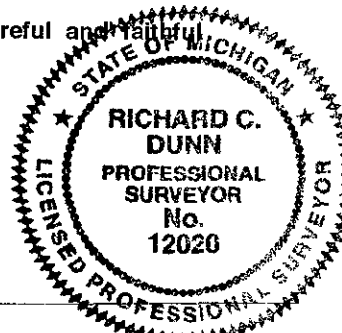

igned by *Richard C. Dunn*
urveyor's Michigan License No. 12020

Date December 15, 1994