

SURVEY & REMONUMENTATION
CHEBOYGAN COUNTY REMONUMENTATION CORNER

MAX 03 1995

LAND CORNER RECORDATION CERTIFICATE
Filing Requirement of Act 74, Mich. P.A. 1970

DEC 29 1994

For corners in
Cheboygan
(County)

COMMISSION

Located In: _____ Corner Code # _____

RECEIVED FOR RECORD
of 12:53 O'Clock P M

Josanne Spray

CLERK/REGISTER
CHEBOYGAN COUNTY, MICHIGAN

Register of Deeds Stamp & File Number

1. Public Land Survey	T <u>35N</u> R <u>1W</u>	<u>A-7</u>
	T _____ R _____	_____
	T _____ R _____	_____
	T _____ R _____	_____
2. Property Controlling in Section	S _____ T _____ R _____	_____
	S _____ T _____ R _____	_____
3. Miscellaneous Property in Sec.	S _____ T _____ R _____	_____
	S _____ T _____ R _____	_____

4. Lot No. _____, Recorded Plat _____
5. Private Claims _____

	A	B	C	D	E	F	G	H	I	J	K	L	M
2	6	5	4	3	2	1							
3													
4	7	8	9	10	11	12							
5													
6	18	17	16	15	14	13							
7													
8	19	20	21	22	23	24							
9													
10	30	29	28	27	26	25							
11													
12	31	32	33	34	35	36							
13													

I, Richard C. Dunn, in a field survey on August, 19 94, do hereby certify that under requirements of P.A. 74, Michigan P.A. of 1970, the corner points mentioned in lines 1 and 2 above were in conformance with regulations and rules therefore as required in the current manual of survey instructions of the United States Department of the Interior, Bureau of Land Management or by a decree of a Court of Law and/or that the corner points mentioned in lines 3, 4 and 5 above were in conformance with the rules of the Michigan Board of Land Surveyors or by a Decree of a Court of Law; established, re-established, monumented, re-monumented, recovered, found as expressed below:

NOTE: Not more than 4 corners, all in the same town and range, may be recorded on this certificate.

A. Description of original monument and accessories and/or subsequent restoration:

G.L.O. John Mullett 1840
Set wood post
12" Cedar N31°E 13 Links
8" Cedar S63°W 8 Links


Dean Delameter #5778
July 1951 Liber A, Page 280
Set 1" Pipe w/4" Brass Cap
8" Cedar S50°W 68 Links
6" Cedar N50°E 84 Links
6" Balsam S73°E 57 Links
No Evidence Fnd.

Orlando Doyle #7319
March 1973 Liber 1, Page 117
Fnd. Old Cedar Stake, iron marked stake alongside.
Set 3/4" Pipe in center of stake
8" Spruce N86°E 30.82'
Pine Stump N25°E 8.80'
Pine Stump S85°W 10.22'

B. Description of corner evidence found and/or method applied in restoring or reestablishing corner:

Fnd. 3/4" Pipe w/Doyle Cap #7319 as recorded in Liber 1, Page 117, Cheboygan County L.C.R. Records.


Maurice P. Ross

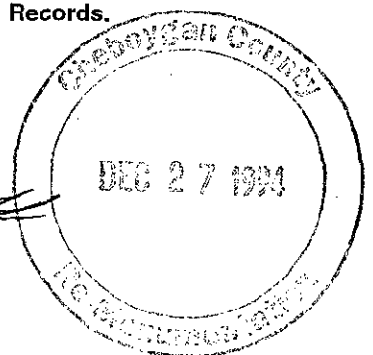

C. Description of monument for corner and accessories established to perpetuate locating the position of the corner:

A-7 Found 3/4" Pipe w/Doyle Cap #7319, replaced with 5/8" x 30" Iron Bar and 3" aluminum cap per Liber 1, Page 117, Cheboygan County Records, and is accepted as a careful and faithful reestablishment of the position of the original corner.
8" quad Cedar E 1.96'
Fence Post S10°E 4.83'
15" Cedar W24.80'
6" Ash N45°W22.03'

LIBER **010** PAGE **101**

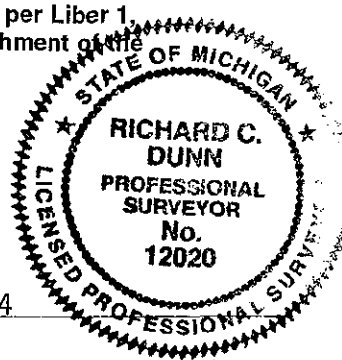

igned by *Richard C. Dunn*

Date December 15, 1994

urveyor's Michigan License No. 12020