

SURVEY & REMONUMENTATION

CHEBOYGAN COUNTY REMONUMENTATION CORNER

MAY 13 1995

LAND CORNER RECORDATION CERTIFICATE

Filing Requirement of Act 74, Mich. P.A. 1970

DEC 29 1994

COMMISSION

For corners in

Cheboygan
(County)

Located In:

Corner Code #

1. Public Land Survey	T	35N	R	1W	A-9
	T		R		
	T		R		
	T		R		
2. Property Controlling in Section	S		T	R	
	S		T	R	
3. Miscellaneous Property in Sec.	S		T	R	
	S		T	R	

RECEIVED FOR RECORD
at 12:59 O'Clock P M

James Gray

CLERK/REGISTER
CHEBOYGAN COUNTY, MICHIGAN

Register of Deeds Stamp & File Number

4. Lot No. _____, Recorded Plat _____
5. Private Claims _____

	A	B	C	D	E	F	G	H	I	J	K	L	M
2	6	5	4	3	2	1							
3													
4	7	8	9	10	11	12							
5													
6	18	17	16	15	14	13							
7													
8	19	20	21	22	23	24							
9													
10	30	29	28	27	26	25							
11													
12	31	32	33	34	35	36							
13													

I, Richard C. Dunn, in a field survey on August, 19 94, do hereby certify that under requirements of P.A. 74, Michigan P.A. of 1970, the corner points mentioned in lines 1 and 2 above were in conformance with regulations and rules therefor as required in the current manual of survey instructions of the United States Department of the Interior, Bureau of Land Management or by a decree of a Court of Law and/or that the corner points mentioned in lines 3, 4 and 5 above were in conformance with the rules of the Michigan Board of Land Surveyors or by a Decree of a Court of Law; established, re-established, monumented, re-monumented, recovered, found as expressed below:

NOTE: Not more than 4 corners, all in the same town and range, may be recorded on this certificate.

A. Description of original monument and accessories and/or subsequent restoration:


G.L.O. John Mullett 1840
14" Birch @ corner

Orlando Doyle #7319
March 1974 Book 1, page 119
Set 1" Pipe
P. Pole #213 N45°W 42.88'
P. Pole #214 S30°E 41.72'
6" Elm N30°E 32.00'

B. Description of corner evidence found and/or method applied in restoring or reestablishing corner:

Fnd. 1" Pipe w/Doyle cap #7319.
Fnd. 6" Elm N30°E 32.00'


Morris D. Ross

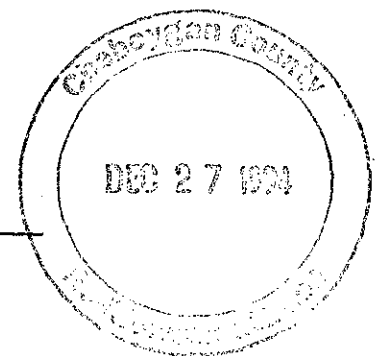

C. Description of monument for corner and accessories established to perpetuate locating the position of the corner:

A-9 Found 1" Pipe w/Doyle Cap #7319, replaced with 5/8" x 30" Iron Bar and 3" aluminum cap per Liber 1, Page 119, Cheboygan County Records, and is accepted as a careful and faithful reestablishment of the position of the original corner.
Stop Sign Post S05°E 73.18'
15" Fir S35°W 69.13'
9" Elm N30°E 31.72'
Fence Post N04°E 33.15'
S85°W 5.0' To Intersection of Ostrander Road & Cross Road

LIBER 010 PAGE 103

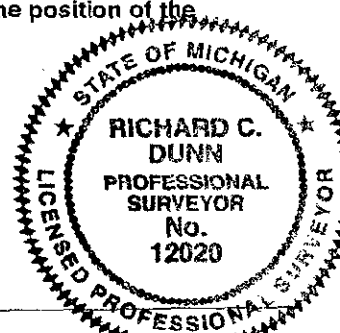

Signed by *Richard C. Dunn*

Date December 15, 1994

Surveyor's Michigan License No. 12020