

SURVEY & REMONUMENTATION

CHEBOYGAN COUNTY REMONUMENTATION CORNER

MAY 1995

LAND CORNER RECORDATION CERTIFICATE
Filing Requirement of Act 74, Mich. P.A. 1970

DEC 29 1994

For corners in **Cheboygan** (County) **COMMISSION**

Located In: Corner Code ##

RECEIVED FOR RECORD
at 12:57 O'Clock P.M.

James Spray
CLERK/REGISTER
CHEBOYGAN COUNTY, MICHIGAN

- | | | |
|------------------------------------|--------------------------|-------------|
| 1. Public Land Survey | T <u>35N</u> R <u>1W</u> | <u>A-11</u> |
| | T _____ R _____ | _____ |
| | T _____ R _____ | _____ |
| | T _____ R _____ | _____ |
| 2. Property Controlling in Section | S _____ T _____ R _____ | _____ |
| | S _____ T _____ R _____ | _____ |
| 3. Miscellaneous Property in Sec. | S _____ T _____ R _____ | _____ |
| | S _____ T _____ R _____ | _____ |

Register of Deeds Stamp & File Number

4. Lot No. _____, Recorded Plat _____
5. Private Claims _____

	A	B	C	D	E	F	G	H	I	J	K	L	M
2	6		5		4		3		2		1		
3													
4	7		8		9		10		11		12		
5													
6	18		17		16		15		14		13		
7													
8	19		20		21		22		23		24		
9													
10	30		29		28		27		26		25		
11													
12	31		32		33		34		35		36		
13													

I, Richard C. Dunn, in a field survey on August, 1994, do hereby certify that under requirements of P.A. 74, Michigan P.A. of 1970, the corner points mentioned in lines 1 and 2 above were in conformance with regulations and rules therefore as required in the current manual of survey instructions of the United States Department of the Interior, Bureau of Land Management or by a decree of a Court of Law and/or that the corner points mentioned in lines 3, 4 and 5 above were in conformance with the rules of the Michigan Board of Land Surveyors or by a Decree of a Court of Law; established, re-established, monumented, re-monumented, recovered, found as expressed below:

NOTE: Not more than 4 corners, all in the same town and range, may be recorded on this certificate.

A. Description of original monument and accessories and/or subsequent restoration:

G.L.O. John Mullett 1840
Set wood post
14" Beech S76°W 7 Links
12" Beech N37°E 52 Links


William Downey #2937
June 1967 Liber A, page 405
Fnd. 1" Sq. Bar
5" Maple S50°W 25.81'
5" Twin Maple S76°E 22.74'
7" Maple Clump S27°E 36.96'

Orlando Doyle #7319
March 1974 Book 1, page 119
Fnd. 1" Sq. Bar
5" Maple S50°W 25.81'
5" Twin Maple S76°E 22.74'
7" Maple Clump S27°E 36.96'

B. Description of corner evidence found and/or method applied in restoring or reestablishing corner:

Fnd. 1" Square Bar
Fnd. 7" Maple Clump S27°E 36.96' (Stumps Only)

Morris A. Ross

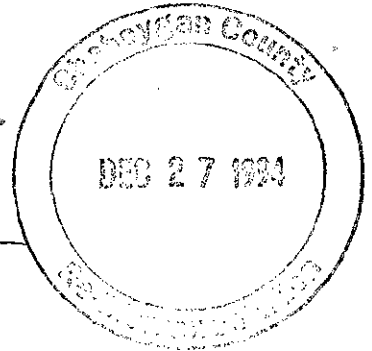

C. Description of monument for corner and accessories established to perpetuate locating the position of the corner:

A-11 Found 1" square bar, replaced with 5/8" x 30" iron bar and 3" aluminum cap per Liber 1, Page 119, Cheboygan County Records and is accepted as a careful and faithful reestablishment of the position of the original corner.
6" Twin Maple S10°E 37.97'
Fence Post N52°E 37.50'
7" Tri Apple N75°W 29.00'
6" Basswood S80°W 22.50'
1' W of Center Line of Cross Road

LIBER 010 PAGE 105



Signed by *Richard C. Dunn*

Date December 15, 1994

Surveyor's Michigan License No. 12020