

SURVEY & REMONUMENTATION

CHEBOYGAN COUNTY REMONUMENTATION CORNER

MAY 13 1995

LAND CORNER RECORDATION CERTIFICATE

DEC 29 1994

Filing Requirement of Act 74, Mich. P.A. 1970

RECEIVED FOR RECORD
of 12:58 O'Clock P M

For corners in **COMMISSION**

Cheboygan (County)	Located In:	Corner Code #
1. Public Land Survey	T 35N R 1W	A-12
	T _____ R _____	_____
	T _____ R _____	_____
	T _____ R _____	_____
2. Property Controlling in Section	S _____ T _____ R _____	_____
	S _____ T _____ R _____	_____
3. Miscellaneous Property in Sec.	S _____ T _____ R _____	_____
	S _____ T _____ R _____	_____

Jessie Spray

CLERK/REGISTER
CHEBOYGAN COUNTY, MICHIGAN

Register of Deeds Stamp & File Number

4. Lot No. _____, Recorded Plat _____
5. Private Claims _____

	A	B	C	D	E	F	G	H	I	J	K	L	M
2	6	5	4	3	2	1							
3													
4	7	8	9	10	11	12							
5													
6	18	17	16	15	14	13							
7													
8	19	20	21	22	23	24							
9													
10	30	29	28	27	26	25							
11													
12	31	32	33	34	35	36							
13													

I, Richard C. Dunn, in a field survey on August, 1994, do hereby certify that under requirements of P.A. 74, Michigan P.A. of 1970, the corner points mentioned in lines 1 and 2 above were in conformance with regulations and rules therefore as required in the current manual of survey instructions of the United States Department of the Interior, Bureau of Land Management or by a decree of a Court of Law and/or that the corner points mentioned in lines 3, 4 and 5 above were in conformance with the rules of the Michigan Board of Land Surveyors or by a Decree of a Court of Law; established, re-established, monumented, re-monumented, recovered, found as expressed below:

NOTE: Not more than 4 corners, all in the same town and range, may be recorded on this certificate.


A. Description of original monument and accessories and/or subsequent restoration:

- | | |
|---|---|
| G.L.O. John Mullett 1840
Set wood post
12" Beech S36°E 11 Links
10" Sugar N06°W 22 Links | William Downey #2937
May 1967 Liber A, page 410
Fnd. rotted stake w/broken stove castings and replaced stake with 3/4" pipe
Gate post West 32.03'
Gate post N62°W 35.26'
Fence post S86°E 34.58'
4" Twin Apple N12°W 76.15' |
|---|---|

B. Description of corner evidence found and/or method applied in restoring or reestablishing corner:

Fnd. 3/4" Pipe as recorded in Liber A, Page 410, Cheboygan County Records.


Marcus A. Ross

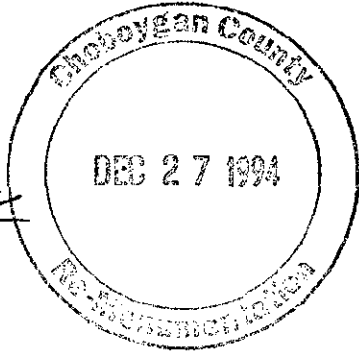

C. Description of monument for corner and accessories established to perpetuate locating the position of the corner:

- A-12 Found 3/4" Pipe, replaced with 5/8" x 30" Iron Bar and 3" aluminum cap per Liber A, Page 410, Cheboygan County Records, and is accepted as a careful and faithful reestablishment of the position of the original corner.
Gate post N72°E 36.66'
8" Twin Apple N12°W 75.83'
7" Twin Apple S80°W 26.85'
5" Cherry S47°E 37.42'
1' East of Center Line Cross Road (Trail)

LIBER 010 PAGE 106

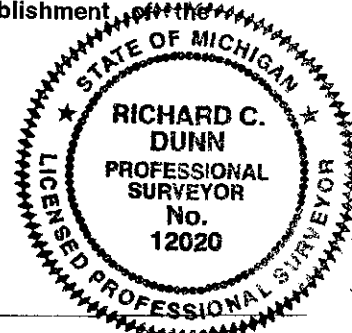

Signed by *Richard C. Dunn* Date December 15, 1994
Surveyor's Michigan License No. 12020