


MICHIGAN  
DEPARTMENT OF CONSERVATION  
FORESTRY DIVISION

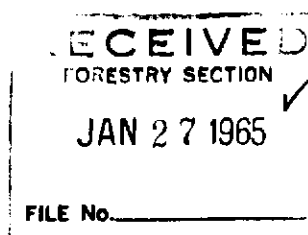

# LAND CORNER RECORD


T. 35 N.R. 1 E.  
T. 35 N.R. 1 W. Cheboygan COUNTY

DESCRIPTION OF CORNER Section corner common to Sections 7 - 18 - 12 - 13

CORNER MONUMENT Set 1" pipe with 4" aluminum cap

DATE MONUMENT PLACED AND WITNESSED November 13, 1964

WITNESSES TO CORNER.....

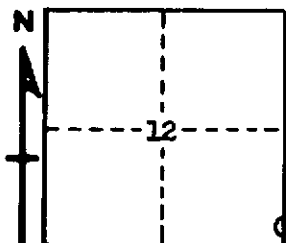

7" R. Oak S 13 E 41.0'

12" Maple N 84 W 33.3'

AND \_\_\_\_\_

CIRCLE CORNER REGISTERED

DESCRIPTION IN DETAIL AS TO HOW CORNER WAS LOCATED AND IDENTIFIED OR RESTORED.

This corner was set by proportionate measurement between corners one mile north and one mile south while making a survey in this area. Could locate nothing for previous corner. Stumps in vicinity, but can find nothing conclusive.

SURVEYOR'S SEAL

SIGNED *Kevin J. Pettig* DATE January 20, 1965  
REGISTERED LAND SURVEYOR #10068