


MICHIGAN  
DEPARTMENT OF CONSERVATION  
FORESTRY DIVISION

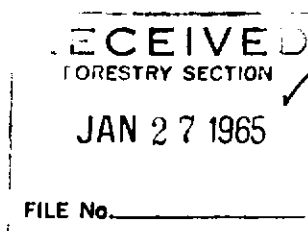

# LAND CORNER RECORD

T. 35 N.R. 1 E.  
T. 35 N.R. 1 W.


Cheboygan COUNTY

DESCRIPTION OF CORNER 1/4 corner common to Sections 6 - 1

CORNER MONUMENT Set 1" pipe with 4" aluminum cap

DATE MONUMENT PLACED AND WITNESSED November 13, 1964

WITNESSES TO CORNER.....

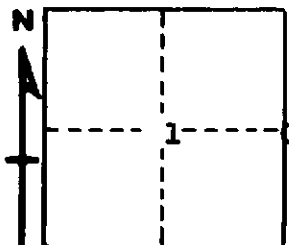

10" Cedar N 87 W 42.6'

7" Cedar N 29 E 24.5'

AND

CIRCLE CORNER REGISTERED

DESCRIPTION IN DETAIL AS TO HOW CORNER WAS LOCATED AND IDENTIFIED OR RESTORED.

This corner was set by proportionate measurement while making a survey in this area. Unable to locate conclusive evidence of original BTs.

SURVEYOR'S SEAL

SIGNED *Ronald J. Peltier* DATE January 20, 1965  
REGISTERED LAND SURVEYOR #10768