

MICHIGAN
DEPARTMENT OF CONSERVATION
FORESTRY DIVISION

LAND CORNER RECORD

T. 35 N.R. 1 W


Cheboygan COUNTY

DESCRIPTION OF CORNER 1/4 corner common to sections 21 and 28

CORNER MONUMENT Set 1" pipe with 1/2" aluminum cap

DATE MONUMENT PLACED AND WITNESSED Sept 29, 1965

WITNESSES TO CORNER.....

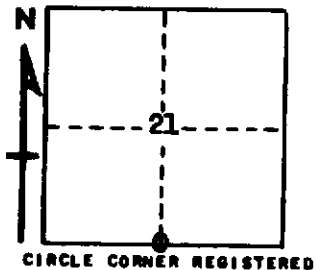

10" Cedar - N 20 E - 74.3°

2" R Pine S 40 W - 45.6

AND

DESCRIPTION IN DETAIL AS TO HOW CORNER WAS LOCATED AND IDENTIFIED OR RESTORED.

This corner was found while making a survey in this township. Found very old squared post at corner, as established by unknown surveyor. Falls nearly at proportionate measurement, and two possible sites for USBTs. Accepted as best available evidence of corner.

SURVEYOR'S SEAL

SIGNED

Kenneth J. Osting
REGISTERED LAND SURVEYOR #20068

DATE October 19, 1965