

✓

MICHIGAN
DEPARTMENT OF CONSERVATION
FORESTRY DIVISION

LAND CORNER RECORD

T. 35 N.R. 1 W


Cheboygan COUNTY

DESCRIPTION OF CORNER Sec corner common to sections: 23, 24, 25 and 26

CORNER MONUMENT Set 1" pipe with 1/4" aluminum cap

DATE MONUMENT PLACED AND WITNESSED Nov. 3, 1965

WITNESSES TO CORNER.....

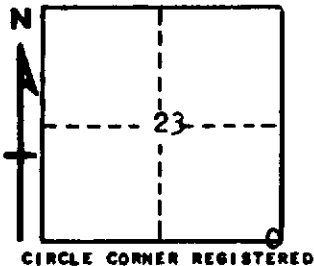

12" Balsam - S 44 W - 24.4

10" Balsam - S 38 E - 46.0

AND

DESCRIPTION IN DETAIL AS TO HOW CORNER WAS LOCATED AND IDENTIFIED OR RESTORED.

This corner was set while making a survey in this area. Set corner on line over, and equidistant from good section and 1/4 corner west. It was felt this method of restoration best fitted the situation since proportionate measurement would create distorted lines not compatible with occupation or physical calls of the U.S. notes.

SURVEYOR'S SEAL

SIGNED *Kenneth J. Osting* DATE Nov. 26, 1965
REGISTERED LAND SURVEYOR # 10068