

MICHIGAN  
DEPARTMENT OF CONSERVATION  
FORESTRY DIVISION

LAND CORNER RECORD

T. 35 N. R. 1W


CHEBOYGAN COUNTY

DESCRIPTION OF CORNER SECTION CORNER COMMON TO SECTIONS 21 - 22 - 27 - 28

CORNER MONUMENT 1" PIPE WITH 4" ALUMINUM CAP

DATE MONUMENT PLACED AND WITNESSED June 24, 1965

WITNESSES TO CORNER.....

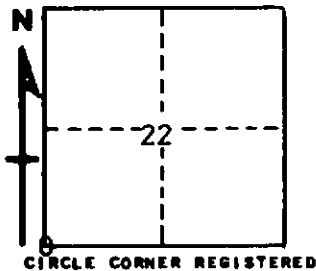

10" RED OAK N33E 13.8'

6" RED OAK N31W 28.3

AND

DESCRIPTION IN DETAIL AS TO HOW CORNER WAS LOCATED AND IDENTIFIED OR RESTORED.

THIS CORNER WAS FOUND WHILE MAKING A SURVEY IN THIS AREA. FOUND VERY OLD SQUARED SCRIBED POST AT CORNER, AS RESTORED IN PREVIOUS SURVEY BY UNKNOWN SURVEYOR. ONE U.S.B.T. STUMP IN PLACE NE WITH POSSIBLE EVIDENCE OF LOWER FACE.

SURVEYOR'S SEAL

SIGNED Kenneth J. Ostling DATE JULY 1, 1965  
REGISTERED LAND SURVEYOR  
K. J. Ostling, #10068