

MICHIGAN
DEPARTMENT OF CONSERVATION
FORESTRY DIVISION

LAND CORNER RECORD

T. 35 N.R. 1W


CHEBOYGAN COUNTY

DESCRIPTION OF CORNER SECTION CORNER COMMON TO SECTIONS 3 - 4 - 9 - 10

CORNER MONUMENT LEFT 6" CONCRETE MONUMENT IN PLACE

DATE MONUMENT PLACED AND WITNESSED JUNE 23, 1965

WITNESSES TO CORNER.....

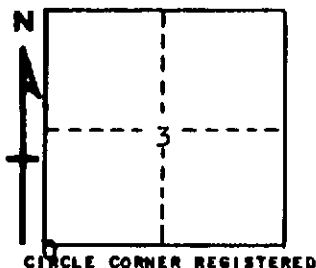

NOTHING NEAR TO WITNESS

AND

DESCRIPTION IN DETAIL AS TO HOW CORNER WAS LOCATED AND IDENTIFIED OR RESTORED.

THIS CORNER WAS FOUND WHILE MAKING A SURVEY IN THIS TOWNSHIP. FOUND 6" CONCRETE MONUMENT AS ESTABLISHED BY BOWEN IN 1914 AND RECORDED. FALLS ABOUT 5' NE OF FENCE INTERSECTION IN OLD FIELD. ALL SURROUNDING AREA APPEARS TO HAVE BEEN FARMED AT SOME PREVIOUS TIME. BEST AVAILABLE EVIDENCE OF PROPER LOCATION FOR CORNER.

SURVEYOR'S SEAL

SIGNED

Kenneth Ostling
REGISTERED LAND SURVEYOR

DATE JUNE 30, 1965

K. J. Ostling #10068