

MICHIGAN  
DEPARTMENT OF CONSERVATION  
FORESTRY DIVISION

# LAND CORNER RECORD

T. 35 N.R. 1 W


Cheboygan COUNTY

DESCRIPTION OF CORNER Sec. corner common to sections 11, 12, 13 and 14

CORNER MONUMENT Set 1" pipe with 1/2" aluminum cap

DATE MONUMENT PLACED AND WITNESSED October 15, 1965

WITNESSES TO CORNER.....

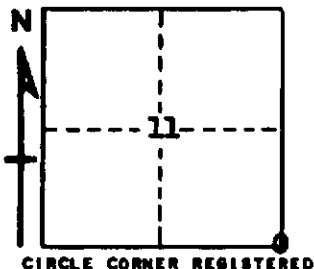

7" H. Maple - N 63 E - 8.4'

8" Beech - S 8 E - 27.5'

AND

DESCRIPTION IN DETAIL AS TO HOW CORNER WAS LOCATED AND IDENTIFIED OR RESTORED.

This corner was set by double proportionate measurement between Section corners 1 mile in all 4 directions. Unable to identify anything for USBTs or a previous corner.

SURVEYOR'S SEAL

SIGNED *Kenneth J. Ostling* DATE October 21, 1965  
REGISTERED LAND SURVEYOR #10068