


MICHIGAN
DEPARTMENT OF CONSERVATION
FORESTRY DIVISION

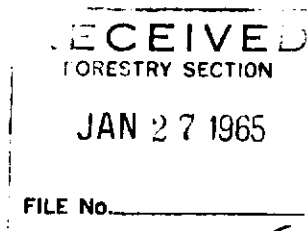

LAND CORNER RECORD

T. 35 N.R. 1 W.


Cheboygan COUNTY

DESCRIPTION OF CORNER 1/4 corner common to Sections 5 - 6

CORNER MONUMENT Set 1" pipe with 4" aluminum cap

DATE MONUMENT PLACED AND WITNESSED November 19, 1964

WITNESSES TO CORNER.....

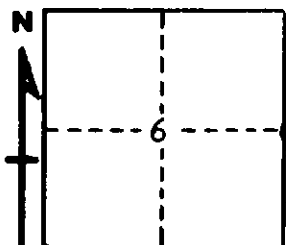

7" Maple N 83 W 83.1'

AND

CIRCLE CORNER REGISTERED

DESCRIPTION IN DETAIL AS TO HOW CORNER WAS LOCATED AND IDENTIFIED OR RESTORED.

This corner was set by proportionate measurement between section corners, taking into account the deflection and unequal measurements of the 1/2 miles.

SURVEYOR'S SEAL

SIGNED

Kenneth D. Billing
REGISTERED LAND SURVEYOR #10068

DATE

January 25, 1965