


MICHIGAN  
DEPARTMENT OF CONSERVATION  
FORESTRY DIVISION

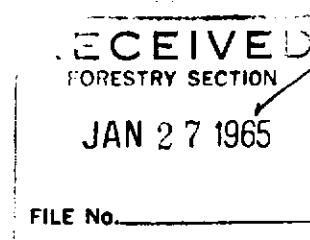

# LAND CORNER RECORD

T. 35 N.R. 1 W.  
T. 36 N.R. 1 W.


Cheboygan COUNTY

DESCRIPTION OF CORNER 1/4 corner common to Sections 6 - 31

CORNER MONUMENT 1" pipe with 4" aluminum cap

DATE MONUMENT PLACED AND WITNESSED November 19, 1964

WITNESSES TO CORNER.....

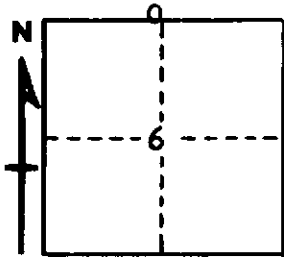

7" H. Maple N 82 E 24.0'

5" H. Maple S 2 W 16.2'

AND

CIRCLE CORNER REGISTERED

DESCRIPTION IN DETAIL AS TO HOW CORNER WAS LOCATED AND IDENTIFIED OR RESTORED.

This corner was set by proportionate measurement between Section corners. No evidence of previous corner or original BTs.

SURVEYOR'S SEAL

SIGNED *Kenneth J. Ostling* DATE January 20, 1965  
REGISTERED LAND SURVEYOR #10088