


MICHIGAN
DEPARTMENT OF CONSERVATION
FORESTRY DIVISION

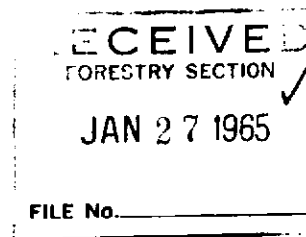

LAND CORNER RECORD


T. 35 N.R. 1 W.
T. 36 N.R. 1 W. Cheboygan COUNTY

DESCRIPTION OF CORNER Section corner common to Sections 1 - 2 - 35 - 36

CORNER MONUMENT Set 1" pipe with 4" aluminum cap

DATE MONUMENT PLACED AND WITNESSED December 4, 1964

WITNESSES TO CORNER..... _____

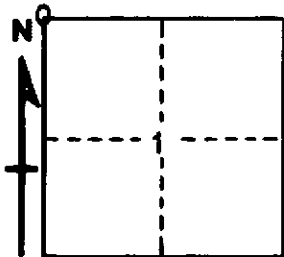

CIRCLE CORNER REGISTERED

8" Cedar S 58 W 8.3'

7" Cedar S 63 E 14.4'

AND _____

DESCRIPTION IN DETAIL AS TO HOW CORNER WAS LOCATED AND IDENTIFIED OR RESTORED.

This corner was found while making a retracement in this township. Found 1 1/2" pipe at corner, and old post, which appears acceptable as proper position for corner. Checks U. S. record for measurement south to U. S. 1/4 corner and falls on line with corners east and west. No remains of U. S. BTs, however..

SURVEYOR'S SEAL

SIGNED *Kenneth A. Pelling* DATE January 25, 1965
REGISTERED LAND SURVEYOR #10068