


MICHIGAN
DEPARTMENT OF CONSERVATION
FORESTRY DIVISION

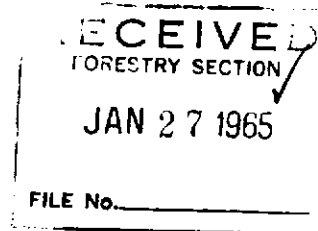

LAND CORNER RECORD

T. 35 N.R. 1 W.
T. 36 N.R. 1 W.


Cheboygan COUNTY

DESCRIPTION OF CORNER 1/4 corner common to Sections 1 - 36

CORNER MONUMENT Set 1" pipe with 4" aluminum cap

DATE MONUMENT PLACED AND WITNESSED December 4, 1964

WITNESSES TO CORNER..... _____

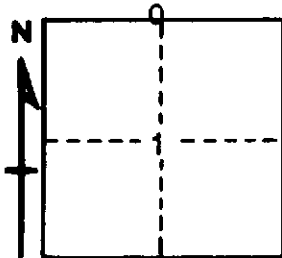

8" Spruce N 25 E 17.6'

7" W. Pine N 40 W 17.3'

AND _____

CIRCLE CORNER REGISTERED

DESCRIPTION IN DETAIL AS TO HOW CORNER WAS LOCATED AND IDENTIFIED OR RESTORED.

This corner was found while making a survey in this township. Found 1 1/2" pipe at corner, which falls on line between section corners but not quite at midpoint. No evidence of original BTs.

SURVEYOR'S SEAL

SIGNED *Rennett J. Ostling* DATE January 25, 1965
REGISTERED LAND SURVEYOR #10068