


MICHIGAN
DEPARTMENT OF CONSERVATION
FORESTRY DIVISION

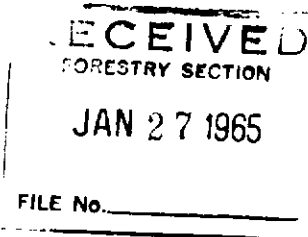

LAND CORNER RECORD

T. 35 N.R. 2 W.


Cheboygan COUNTY

DESCRIPTION OF CORNER 1/4 corner common to Sections 1 - 2

CORNER MONUMENT Set 1" pipe with 4" brass cap

DATE MONUMENT PLACED AND WITNESSED September 3, 1964

WITNESSES TO CORNER.....

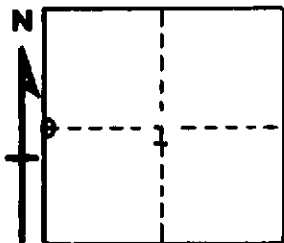

CIRCLE CORNER REGISTERED

8" J. Pine N 60 E 56.1'

8" J. Pine S 15 W 16.5'

AND

DESCRIPTION IN DETAIL AS TO HOW CORNER WAS LOCATED AND IDENTIFIED OR RESTORED.

This corner was set by proportionate measurement between section corners, while making a survey in this township. Nothing left for U.S.B.Ts.

SURVEYOR'S SEAL

SIGNED *Kenneth J. Ostling* DATE January 20, 1965
REGISTERED LAND SURVEYOR #10068