

MICHIGAN  
DEPARTMENT OF CONSERVATION  
FORESTRY DIVISION

LAND CORNER RECORD

T. 35 N.R. 2 W


Cheboygan COUNTY

DESCRIPTION OF CORNER 1/4 corner common to Sections 21-22

CORNER MONUMENT Set 1" pipe with 1/4" aluminum cap

DATE MONUMENT PLACED AND WITNESSED April 13, 1966

WITNESSES TO CORNER.....

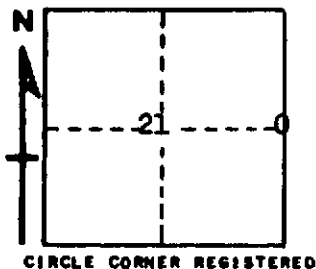

16" J. Pine N 70 E 65.1'

16" B. Oak S 47 E 206.00'

AND

DESCRIPTION IN DETAIL AS TO HOW CORNER WAS LOCATED AND IDENTIFIED OR RESTORED.

This corner was set by proportionate measurement  
between Section corners while making a survey of Section 21.  
Good corners north and south.

SURVEYOR'S SEAL

SIGNED Kenneth J. Osting DATE April 28, 1966  
REGISTERED LAND SURVEYOR #10068