

LAND CORNER RECORDATION CERTIFICATE

Filing Requirement of Act 74, Mich. PA 1970

For Corners In:
Cheboygan Located In _____ Corner Code # _____
 (County)

1. Public Land Survey	T	<u>35 N</u>	R	<u>2 W</u>	<u>B-9</u>
	T	<u>35 N</u>	R	<u>2 W</u>	<u>C-10</u>
2. Property Controlling in Section	S	_____	T	_____	_____
	S	_____	T	_____	_____
3. Miscellaneous Property in Section	S	_____	T	_____	_____
	S	_____	T	_____	_____


4. Lot No: _____ Recorded Plat: _____

5. Private Claims: _____

I, Carl T. Kiiskila, in a field survey on July 18, 2001 do hereby state that under requirements of PA 74, Michigan PA of 1970, the corner points mentioned in lines 1 and 2 above were in conformance with regulations and rules therefore as required in the current manual of survey instructions of the United States Department of the Interior, Bureau of Land Management or by a decree of a Court of Law and/or that the corner points mentioned in lines 3, 4 and 5 above were in conformance with the rules of the Michigan Board of Land Surveyors or by a Decree of a Court of Law; established, re-established, monumented, recovered, found as expressed below:

NOTE: Not more than 2 corners, all in the same town and range, may be recorded on this certificate.

Register of Deeds Stamp & File Number

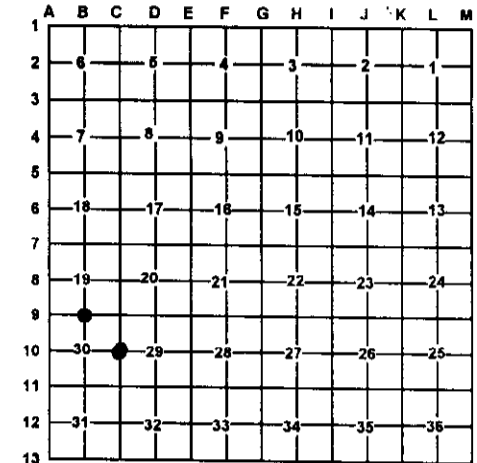

A. Description of original monument and accessories and/or subsequent restoration:

B-9 G.L.O. Harvey Mullen D.S. 1855
 Set quarter section post
 Wit: Cedar 24" N75°W 15 Links
 Cedar 12" N33°E 23 Links

Ronald R. Bischer RLS #22428 Oct. 1983 liber 1, page 325,
 Found 5/8" pipe by M.S.H.D. 1960.
 Wit: N18°W 10.01' 8" Cedar, N70°E 11.48' 16" Cedar
 S80°W 11.04' 6" Black Ash

C-10 G.L.O. Harvey Mullen D.S. 1855
 Set quarter section post in stream, 30 links, course west
 Wit: Black Ash 12 S2°W 32 links
 Cedar 9 N21°W 34 links

Norman Caldwell RLS #12018 Dec. 1960 Found remains of original bearing tree. Set 3 X 3 wood stake in stream also set 1/2" iron rod 5' long along side and 3' below water surface and 8" above stream bed Wit: N25°W 19.08' 17" Cedar N30°E 14.45' 15" Cedar, S60°W 21.44' 11" Cedar, S05°E 27.88' 12" White Birch N21°W Original B.T. 22.44' stump

William R. Downey RLS #2937 March 1967 Found 1/2" rod in stream. Wit: N25°W 19.08' 17" Cedar, N30°E 14.45' 15" Cedar S60°W 21.44' 11" cedar, S05°E 37.88' 12" Birch N21°W 22.44' stump (original B.T.)

B. Description of corner evidence found and/or method applies in restoring or re-establishing corner:

B-9 Found 5/8" pipe

C-10 Found 1/2" rod in stream

C. Description of monument for corner and accessories established to perpetuate locating the position of the corner:

B-9 Left 5/8" pipe in place
 Wit: *14" Cedar N85°E 11.37'
 6" Balsam S51°E 8.32'
 *6" Ash S79°W 11.08'
 8" Cedar N37°E 29.11'
 Carsonite Post North 1'±

C-10 Left 1/2" rod 16" below water surface of little Sturgeon River in place
 Wit: 20" Cedar N30°E 13.98'
 18" Cedar N28°W 18.59'
 12" Cedar S28°E 18.32'
 12" Cedar S58°W 20.22'

*Old witnesses by others

Signed by: Carl T. Kiiskila
 Surveyor's Michigan License No.: 33981

Date: 1-10-02

