


LAND CORNER RECORDATION CERTIFICATE


Filing Requirement of Act 74, Mich. PA 1970

For Corners In: Cheboygan (County)	Located In	Corner Code #
1. Public Land Survey	T <u>35 N</u> R <u>2 W</u>	<u>C-11</u>
	T <u>35 N</u> R <u>2 W</u>	<u>C-12</u>
2. Property Controlling in Section	S _____ T _____ R _____	_____
	S _____ T _____ R _____	_____
3. Miscellaneous Property in Section	S _____ T _____ R _____	_____
	S _____ T _____ R _____	_____
4. Lot No: _____	Recorded Plat: _____	
5. Private Claims: _____		

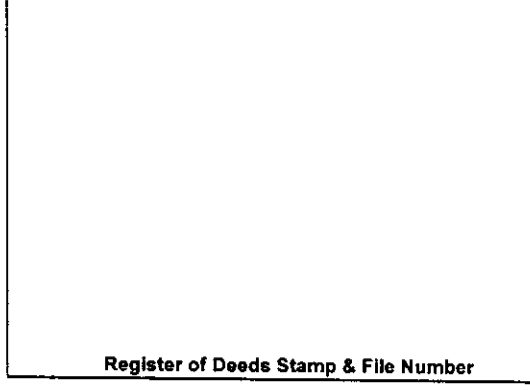

I, Carl T. Kiiskila, in a field survey on July 18, 2001 do hereby state that under requirements of PA 74, Michigan PA of 1970, the corner points mentioned in lines 1 and 2 above were in conformance with regulations and rules therefore as required in the current manual of survey instructions of the United States Department of the Interior, Bureau of Land Management or by a decree of a Court of Law and/or that the corner points mentioned in lines 3, 4 and 5 above were in conformance with the rules of the Michigan Board of Land Surveyors or by a Decree of a Court of Law; established, re-established, monumented, recovered, found as expressed below:

NOTE: Not more than 2 corners, all in the same town and range, may be recorded on this certificate.

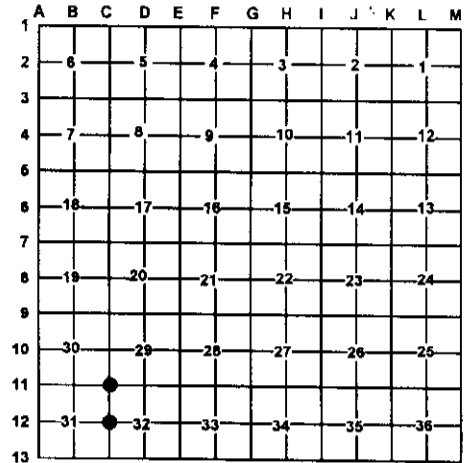

A. Description of original monument and accessories and/or subsequent restoration:

- | | |
|---|--|
| C-11 G.L.O. Harvey Mullen D.S. 1855
Set corner section post 29,30,31 and 32
Wit: White Pine 16 S39°E 1.16 chains
Cedar 15 N18°E 72 links | C-12 G.L.O. Harvey Mullet D.S. 1855
Set quarter section post
Wit: Spruce Pine 6 North 1 link
Spruce Pine 6 S66°W 6 links |
| Kenneth J. Ostling RLS #10068 Sept. 1960 restored corner form original BT's both in place. Set 1" pipe with 4" brass cap. Wit: 14" Jack Pine N67°W 289 links, 20" Elm bears S35°W | Kenneth J. Ostling RLS #10068 Dec. 1960 Set 1" pipe with brass cap by proportionate measurement Wit: 7" Jack Pine N86°W 103.5 links, 10" Jack Pine S22°W 167.5 links |
| | William R. Downey RLS #2937 March 1967. Found 4" brass cap on 1" pipe set by Dept. of Conservation. Wit: N86°W 68.31' 7" Jack Pine, S22°W 110.55' 10" Jack Pine |

B. Description of corner evidence found and/or method applies in restoring or re-establishing corner:

- | | |
|-------------------------|---|
| C-11 Found DNR monument | C-12 Found 1/2" rod with P.S. cap #41099 B.K.F. |
|-------------------------|---|

C. Description of monument for corner and accessories established to perpetuate locating the position of the corner:

- | | |
|--|---|
| C-11 DNR monument
Wit: Power Pole N60°E 71.97'
8" Poplar S40°E 25.25'
8" Poplar S76°W 54.65'
12" Poplar N44°W 55.90' | C-12 Set D.N.R. monument
Wit: *5" Maple S78°E 37.74'
*9" Jack Pine N34°E 30.62'
18" Oak S12°W 102.98'
*10" Jack Pine N78°W 68.46'
Carsonite Post North 1'± |
|--|---|

Signed by: Carl T. Kiiskila
 Surveyor's Michigan License No.: 33981

Date: 1-10-02

