

LAND CORNER RECORDATION CERTIFICATE

Filing Requirement of Act 74, Mich. PA 1970


For Corners In: Cheboygan (County)	Located In	Corner Code #	
1. Public Land Survey	T 35 N R 2 W	B-13	
	T 35 N R 2 W	C-13	
2. Property Controlling in Section	S _____ T _____ R _____		
	S _____ T _____ R _____		
3. Miscellaneous Property in Section	S _____ T _____ R _____		
	S _____ T _____ R _____		

Register of Deeds Stamp & File Number

4. Lot No: _____ Recorded Plat: _____

5. Private Claims: _____

I, Carl T. Kiiskila, in a field survey on July 18, 2001 do hereby state that under requirements of PA 74, Michigan PA of 1970, the corner points mentioned in lines 1 and 2 above were in conformance with regulations and rules therefore as required in the current manual of survey instructions of the United States Department of the Interior, Bureau of Land Management or by a decree of a Court of Law and/or that the corner points mentioned in lines 3, 4 and 5 above were in conformance with the rules of the Michigan Board of Land Surveyors or by a Decree of a Court of Law; established, re-established, monumented, recovered, found as expressed below:

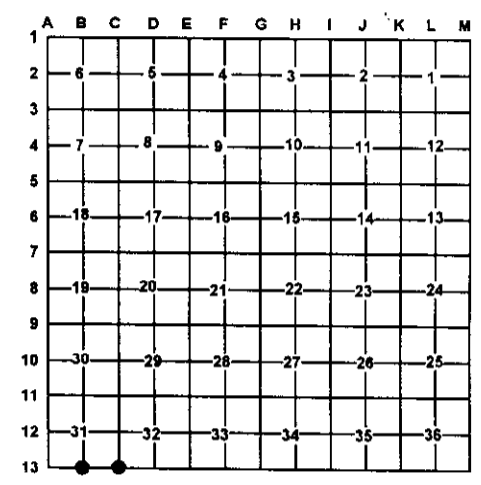

NOTE: Not more than 2 corners, all in the same town and range, may be recorded on this certificate.

A. Description of original monument and accessories and/or subsequent restoration:

B-13 G.L.O. John Mullet D.S. 1840
Set quarter section post
Wit: Pine 16 N12°W 9 links
Pine 14 N86°E 55 links

C-13 G.L.O. John Mullet D.S. 1840
Set post corner section 31 and 32.
Wit: Pine 12" N24°E 19 links
Pine 12" N60W 19 links

Kenneth J. Ostling RLS #10068 Dec. 1960 Established the South quarter corner of section 31 by proportionate measurement between section corners. Set 1" pipe with 4" brass cap.
Wit: 7" Jack Pine N80°E 11.5 links
8" Jack Pine N33°W 16.6 links

Kenneth J. Ostling RLS #10068 Dec. 1960. Established the Southeast corner of section 31 by double proportionate measure. Set 1" pipe with 4" brass cap
Wit: 14" Black Oak South 7.5 links
10" Black Oak N04°W 66.5 links
10" Jack Pine N69°W 36.5 links

B. Description of corner evidence found and/or method applies in restoring or re-establishing corner:

B-13 Found DNR monument

C-13 Found DNR monument



C. Description of monument for corner and accessories established to perpetuate locating the position of the corner:

B-13 DNR monument
Wit: 3" Maple S11°W 24.91'
2" Jack Pine East 14.26'
2" Jack Pine N20°E 16.99'
2" Jack Pine N55°W 19.38'
Centerline of East West trail road south 36'±

C-13 DNR Monument
*14" Jack Pine N55°W 24.06'
*18" Oak N08°E 44.04'
*6-5" triple Maple N83°E 30.96'
*18" Oak S12°W 5.39'

* Old witnesses by others

Signed by: Carl T. Kiiskila
Surveyor's Michigan License No.: 33981

Date: 1-10-02