

# LAND CORNER RECORDATION CERTIFICATE

Filing Requirement of Act 74, Mich. PA 1970

For Corners In:  
Cheboygan Located In \_\_\_\_\_ Corner Code # \_\_\_\_\_  
 (County)

- |                                      |   |       |   |       |       |       |
|--------------------------------------|---|-------|---|-------|-------|-------|
| 1. Public Land Survey                | T | 35N   | R | 2W    | J-2   |       |
|                                      | T | _____ | R | _____ | _____ |       |
| 2. Property Controlling in Section   | S | 2     | T | 35N   | R 2W  | 1     |
|                                      | S | _____ | T | _____ | R     | _____ |
| 3. Miscellaneous Property in Section | S | _____ | T | _____ | R     | _____ |
|                                      | S | _____ | T | _____ | R     | _____ |

4. Lot No: \_\_\_\_\_ Recorded Plat: \_\_\_\_\_

5. Private Claims: \_\_\_\_\_

I, Carl T. Kiiskila, in a field survey on February 28, 2002 do hereby state that under requirements of PA 74, Michigan PA of 1970, the corner points mentioned in lines 1 and 2 above were in conformance with regulations and rules therefore as required in the current manual of survey instructions of the United States Department of the Interior, Bureau of Land Management or by a decree of a Court of Law and/or that the corner points mentioned in lines 3, 4 and 5 above were in conformance with the rules of the Michigan Board of Land Surveyors or by a Decree of a Court of Law; established, re-established, monumented, recovered, found as expressed below:

**NOTE: Not more than 2 corners, all in the same town and range, may be recorded on this certificate.**

**Register of Deeds Stamp & File Number**

	A	B	C	D	E	F	G	H	I	J	K	L	M
1													
2	6		5		4		3			2		1	
3													
4	7		8		9		10			11		12	
5													
6	18		17		16		15			14		13	
7													
8	19		20		21		22			23		24	
9													
10	30		29		28		27			26		25	
11													
12	31		32		33		34			35		36	
13													

A. Description of original monument and accessories and/or subsequent restoration:

J-2 This corner position was not established during the original government survey.

1- This corner position was not established during the original government survey.

B. Description of corner evidence found and/or method applies in restoring or re-establishing corner:

J-2 Established the center of section 2 at the intersection of the North-South and East - West one quarter lines.

1- Established the Northwest corner of the Northeast quarter of the Northwest quarter of section 2 per standard B.L.M. instructions for subdivisions of a section.


C. Description of monument for corner and accessories established to perpetuate locating the position of the corner:

J-2 Set 5/8" X 32" rered with P.S. cap #33981

1-Set 5/8" X 32" rered with P.S. cap #33981

- |                  |       |        |
|------------------|-------|--------|
| Wit: 16" W. Pine | S83°E | 24.16' |
| 8" J. Pine       | S12°E | 33.66' |
| 4" W. Pine       | S80°W | 47.12' |
| 10" W. Pine      | N07°W | 73.67' |
| Carsonite Post   | North | 1±     |

- |                    |       |        |
|--------------------|-------|--------|
| Wit: 8" Twin Cedar | N52°W | 13.50' |
| 8" Cedar           | S27°W | 18.91' |
| 4" Maple           | N84°E | 29.22' |
| 4" Maple           | S56°E | 34.46' |
| Carsonite Post     | North | 1±     |

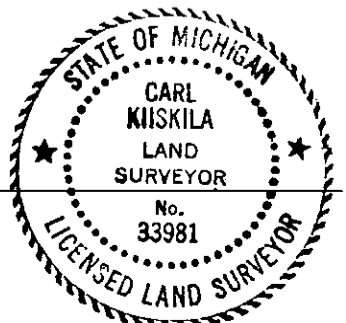

Signed by: Carl T. Kiiskila

Date: 7-17-02

Surveyor's Michigan License No.: 33981