

LAND CORNER RECORDATION CERTIFICATE

Filing Requirement of Act 74, Mich. PA 1970

For Corners In:
Cheboygan Located In _____ Corner Code # _____
 (County)

1. Public Land Survey	T	<u>35N</u>	R	<u>2W</u>	<u>J-3</u>
	T	_____	R	_____	_____
2. Property Controlling in Section	S	_____	T	_____	_____
	S	_____	T	_____	_____
3. Miscellaneous Property in Section	S	_____	T	_____	_____
	S	_____	T	_____	_____


4. Lot No: _____ Recorded Plat: _____

5. Private Claims: _____

I, Carl T. Kiiskila, in a field survey on June 6, 2002 do hereby state that under requirements of PA 74, Michigan PA of 1970, the corner points mentioned in lines 1 and 2 above were in conformance with regulations and rules therefore as required in the current manual of survey instructions of the United States Department of the Interior, Bureau of Land Management or by a decree of a Court of Law and/or that the corner points mentioned in lines 3, 4 and 5 above were in conformance with the rules of the Michigan Board of Land Surveyors or by a Decree of a Court of Law; established, re-established, monumented, recovered, found as expressed below:

NOTE: Not more than 2 corners, all in the same town and range, may be recorded on this certificate.

Register of Deeds Stamp & File Number

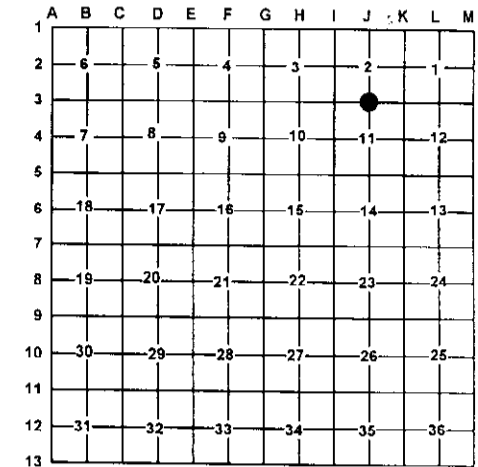

A. Description of original monument and accessories and/or subsequent restoration:

J-3 G.L.O. Harvey Mullen 1855
 Set quarter section post
 Wit: Yellow Pine 16 S68°E 15 links
 Yellow Pine 20 S30°W 33 links

Brian K. Fullford P.S. #41099 tied to this corner while doing a mortgage report in the area in 1994. No type of monument or witnesses were given.

Marvin A. Ross P.S. #16051 used this corner while doing a survey for the Koehler Township cemetery.

B. Description of corner evidence found and/or method applies in restoring or re-establishing corner:

J-3 Found a 1/2" X 18" rod with P.S. cap #16051 driven over a 1" pipe 18" below grade. This position seems to fit the old part of the cemetery to the South and occupation to the Northwest.

C. Description of monument for corner and accessories established to perpetuate locating the position of the corner:

J-3 Set a 1" X 24" pipe with a 4" aluminum DNR cap in monument box.
 Wit: 30" triple Oak S62°W 58.98'
 P. Pole N67°E 58.20'
 6" W. Pine N15°E 91.47'
 26" Maple clump N44°W 103.87'



Signed by: Carl T. Kiiskila
 Surveyor's Michigan License No.: 33981

Date: 7-17-02