


**LAND CORNER RECORDATION CERTIFICATE**  
Filing Requirement of Act 74, Mich. PA 1970

For Corners In: Cheboygan (County)	Located In	Corner Code #
1. Public Land Survey	T 35N R 2W	I-3
2. Property Controlling in Section	T _____ R _____	_____
3. Miscellaneous Property in Section	S _____ T _____ R _____	_____
4. Lot No: _____	Recorded Plat: _____	
5. Private Claims: _____		

Register of Deeds Stamp & File Number

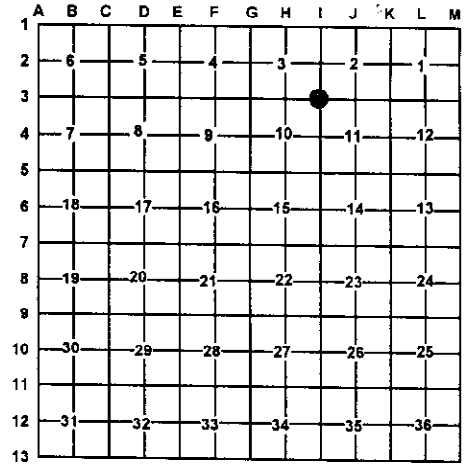

I, Carl T. Kiiskila, in a field survey on June 6, 2002 do hereby state that under requirements of PA 74, Michigan PA of 1970, the corner points mentioned in lines 1 and 2 above were in conformance with regulations and rules therefore as required in the current manual of survey instructions of the United States Department of the Interior, Bureau of Land Management or by a decree of a Court of Law and/or that the corner points mentioned in lines 3, 4 and 5 above were in conformance with the rules of the Michigan Board of Land Surveyors or by a Decree of a Court of Law; established, re-established, monumented, recovered, found as expressed below:

**NOTE: Not more than 2 corners, all in the same town and range, may be recorded on this certificate.**

A. Description of original monument and accessories and/or subsequent restoration:

I-3 G.L.O. Harvey Mullen 1855  
Set Post corner of section 2,3,10 and 11  
Wit: Hemlock 30 N53°W 53 links  
Hemlock 20 S56°E 26 links

September 1964, Kenneth J. Ostling R.L.S. #10068 used this corner for prorating the West 1/4 corner of section 2, 1/2 mile to the North. Type of monument or witnesses were not given.

Brian K. Fullford P.S. # 41099 tied to this corner while doing a mortgage report in the area in 1994. Type of monument or witnesses were not given.

B. Description of corner evidence found and/or method applies in restoring or re-establishing corner:

I-3 Found a 3/4" X 18" pipe fitting Brain K. Fullford's distance East and Kenneth J. Ostling's survey in section 2. Corner falls in the center of an East-West paved road.

C. Description of monument for corner and accessories established to perpetuate locating the position of the corner:

I-3 Set a 1" X 24" pipe with a 4" aluminum cap in a monument box.  
Wit: 8" Maple clump North 86.65'  
4" White Pine N28°E 99.65'  
12" White Pine N54°E 122.21'  
12" Maple S 57°E 90.64'  
8" Maple South 69.70'



Signed by: Carl T Kiiskila  
Surveyor's Michigan License No.: 33981

Date: 7-17-02