

**SURVEY &  
REMONUMENTATION**

1997 CHEBOYGAN COUNTY, STATE OF MICHIGAN REMONUMENTATION **FEB 26 1998**

**LAND CORNER RECORDATION CERTIFICATE  
Filing Requirement of Act 74, Mich. P.A. 1970**

**SECTION**

For corners in

<u>CHEBOYGAN</u> (County)	Located In:	Corner Code #
1. Public Land Survey	T <u>35</u> NR <u>3W</u>	<u>K-5</u>
	T <u>   </u> R <u>   </u>	<u>   </u>
	T <u>   </u> R <u>   </u>	<u>   </u>
	T <u>   </u> R <u>   </u>	<u>   </u>
2. Property Controlling in Section	S <u>   </u> T <u>   </u> R <u>   </u>	<u>   </u>
	S <u>   </u> T <u>   </u> R <u>   </u>	<u>   </u>
3. Miscellaneous Property in Sec.	S <u>   </u> T <u>   </u> R <u>   </u>	<u>   </u>
	S <u>   </u> T <u>   </u> R <u>   </u>	<u>   </u>

12-22-97  
RECEIVED FOR RECORD  
at 9:09 O'Clock A M  
*Joanne Spray*  
CLERK/REGISTER  
CHEBOYGAN COUNTY, MICHIGAN  
Register of Deeds Stamp & File Number

4. Lot No. \_\_\_\_\_, Recorded Plat \_\_\_\_\_  
5. Private Claims \_\_\_\_\_

A	B	C	D	E	F	G	H	I	J	K	L	M
1												
2	6		5		4		3		2		1	
3												
4	7		8		9		10		11		12	
5												
6	10		17		16		15		14		13	
7												
8	19		20		21		22		23		24	
9												
10	30		29		28		27		26		25	
11												
12	31		32		33		34		35		36	
13												

I, Ronald Bischer, in a field survey on Oct 1, 1997 do hereby state that under requirements of P.A. 74, Michigan P.A. of 1970, the corner points mentioned in lines 1 and 2 above were in conformance with regulations and rules therefore as required in the current manual of survey instructions of the United States Department of the Interior, Bureau of Land Management or by a decree of a Court of Law and/or that the corner points mentioned in lines 3, 4 and 5 above were in conformance with the rules of the Michigan Board of Land Surveyors or by a Decree of a Court of Law; established, re-established, monumented, recovered, found as expressed below:


NOTE: Not more than 2 corners, all in the same town and range, may be recorded on this certificate.

A. Description of original monument and accessories and/or subsequent restoration:

K-5	1953 Orlando Doyle #7319
GLO Notes	set conc. mon and 3 witnesses
Harvey Mellen	1962 Dean DelaMater #5778
1855 Resurvey	Found Conc. Mon and set 2 new witnesses
Set Post	1982 Ronald Bischer #22428
21" White Pine N70° W 20 lks	found Conc. Mon and Doyle witnesses
16" White Pine S58° E 17 lks	1990 James Granger #16041
	found conc. mon and Doyle witnesses

B. Description of corner evidence found and/or method applied in restoring or reestablishing corner.


K-5  
Found conc. mon and remains of both original trees in place  
also found 9 witness trees -- Doyle's, Delamaters, Bischer's and Granger's  
Set Remon Cap on Conc. Mon.

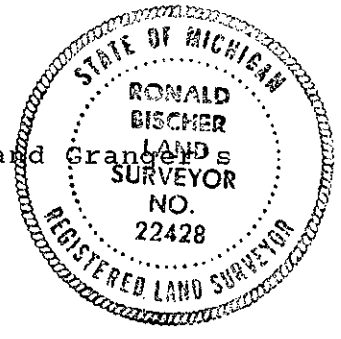

LIBER **011** PAGE **57**

C. Description of monument for corner and accessories established to perpetuate locating the position of the corner:

K-5	Conc. Mon. with Remon Cap	
S64° E	40.25'	16" White Birch Doyle witness
N38° E	35.20'	15" Norway Doyle witness
N37° W	32.45'	20" White Pine Doyle witness
S58° E	6.10'	12" Oak DelaMater witness
S30° W	26.80'	12" White Pine DelaMater witness
N11° W	17.47'	12" Norway Granger witness

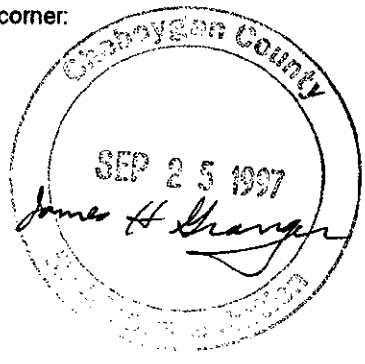

Signed by Ronald R. Bischer Date Oct. 10, 1997  
Surveyor's Michigan License No. 22428