

**SURVEY &
REMONUMENTATION**

1997 CHEBOYGAN COUNTY, STATE OF MICHIGAN REMONUMENTATION FEB 26 1998

LAND CORNER RECORDATION CERTIFICATE
Filing Requirement of Act 74, Mich. P.A. 1970

SECTION

For corners in

<u>CHEBOYGAN</u> (County)	Located In:	Corner Code #
1. Public Land Survey	T <u>35</u> NR <u>3</u> W	<u>K-7</u>
	T ___ R ___	_____
	T ___ R ___	_____
	T ___ R ___	_____
2. Property Controlling in Section	S ___ T ___ R ___	_____
	S ___ T ___ R ___	_____
3. Miscellaneous Property in Sec.	S ___ T ___ R ___	_____
	S ___ T ___ R ___	_____

10-20-97
RECEIVED FOR RECORD
at 9:11 O'Clock A M
James Gray
CLERK/REGISTER
CHEBOYGAN COUNTY, MICHIGAN
Register of Deeds Stamp & File Number

4. Lot No. _____, Recorded Plat _____
5. Private Claims _____

Ronald Bischer, in a field survey on Oct 8, 19 97 do hereby state that under requirements of P.A. 74, Michigan P.A. of 1970, the corner points mentioned in lines 1 and 2 above were in conformance with regulations and rules therefore as required in the current manual of survey instructions of the United States Department of the Interior, Bureau of Land Management or by a decree of a Court of Law and /or that the corner points mentioned in lines 3, 4 and 5 above were in conformance with the rules of the Michigan Board of Land Surveyors or by a Decree of a Court of Law; established, re-established, monumented, recovered, found as expressed below:

NOTE: Not more than 2 corners, all in the same town and range, may be recorded on this certificate.


A	B	C	D	E	F	G	H	I	J	K	L	M
1												
2	6		5		4		3		2		1	
3												
4	7		8		9		10		11		12	
5												
6	18		17		16		15		14		13	
7												
8	19		20		21		22		23		24	
9												
10	30		29		28		27		26		25	
11												
12	31		32		33		34		35		36	
13												

A. Description of original monument and accessories and/or subsequent restoration:

K-7	1962 Dean DeLaMater #5778
GL0 Notes	Found 4" Square Mon. with 1" pipe and 2 witnesses
Harvey Mellen	1988 Michael Trowbridge #27463
1855 Resurvey	Found 4" Sq. Mon. and 4 witnesses
Set Post	1990 James Granger #16041
12" Hemlock N32° E 28 lks	1" pipe in Concrete and 3 new witnesses
14" Cedar S32° W 8 lks	

B. Description of corner evidence found and/or method applied in restoring or reestablishing corner:

K-7
Found 4" Square Monument with 1" pipe and also found 3 Trowbridge witnesses and three Granger Witnesses
Set 5/8" Rod and Remon Cap in 1" pipe

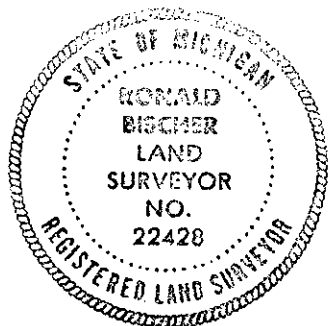


LIBER **011** PAGE **59**

C. Description of monument for corner and accessories established to perpetuate locating the position of the corner:

K-7
5/8" and Remon Cap in 1" pipe in 4" Square concrete monument

S78° W	31.20'	13" Cedar
S46° E	23.67'	8" Ash
North	34.09'	11" White Pine
S25° W	37.36'	13" Hemlock

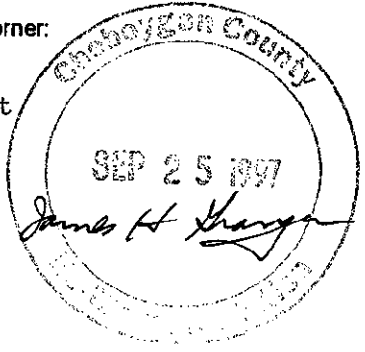

Signed by Ronald R. Bischer Date Oct. 10, 1997
Surveyor's Michigan License No. 22428