

FEB 26 1998

LAND CORNER RECORDATION CERTIFICATE
Filing Requirement of Act 74, Mich. P.A. 1970

SECTION

For corners in

CHEBOYGAN
(County)

Located In:

Corner Code #

12-22-97
RECEIVED FOR RECORD
at 9:12 O'Clock A M

Joanne Spray

CLERK/REGISTER
CHEBOYGAN COUNTY, MICHIGAN

Register of Deeds Stamp & File Number

1. Public Land Survey

T35NR 3W K-10

T	R	_____
T	R	_____
T	R	_____
T	R	_____
T	R	_____
T	R	_____
T	R	_____
T	R	_____

2. Property Controlling in Section

S	T	R	_____
S	T	R	_____
S	T	R	_____
S	T	R	_____
S	T	R	_____

3. Miscellaneous Property in Sec.

4. Lot No. _____, Recorded Plat _____

5. Private Claims _____

I, Ronald Bischer, in a field survey on Oct 9, 19 97 do hereby state that under requirements of P.A. 74, Michigan P.A. of 1970, the corner points mentioned in lines 1 and 2 above were in conformance with regulations and rules therefore as required in the current manual of survey instructions of the United States Department of the Interior, Bureau of Land Management or by a decree of a Court of Law and for that the corner points mentioned in lines 3, 4 and 5 above were in conformance with the rules of the Michigan Board of Land Surveyors or by a Decree of a Court of Law; established, re-established, monumented, recovered, found as expressed below:

NOTE: Not more than 2 corners, all in the same town and range, may be recorded on this certificate.

1	A	B	C	D	E	F	G	H	I	J	K	L	M
2		6		5		4		3		2		1	
3													
4		7		8		9		10		11		12	
5													
6		18		17		16		15		14		13	
7													
8		19		20		21		22		23		24	
9													
10		30		29		28		27		26		25	
11													
12		31		32		33		34		35		36	
13													


A. Description of original monument and accessories and/or subsequent restoration:

K-10
GLO notes
Harvey Mellen
1855 Resurvey
Set Post
20" Yellow Pine N71° E 10 lks
10" Spruce pine N32° W 86 lks

1947 William Blake #2731
Set boat spike
1966 Oriando Doyle #7319
found boat spike set 4 witnesses
1980 Delmer Porter #15410
found 1" pipe in Mon. Box set 4 witnesses
1989 Clifford Lindgren #14098
Set 1/2" Rod in Mon. Box and 4 witnesses

B. Description of corner evidence found and/or method applied in restoring or reestablishing corner:

K-10
Found 1/2" rod in Mon. Box
Found 1 Porter witness
and 4 Lindgren witnesses
Replaced 1/2" rod with 5/8" rod and Remon cap

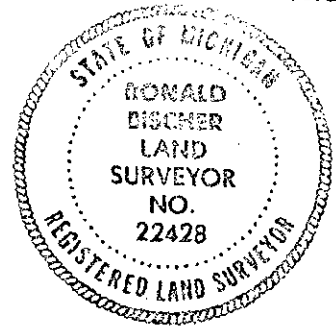


LIBER 011 PAGE 60

C. Description of monument for corner and accessories established to perpetuate locating the position of the corner:

K-10
5/8" Rod and Remon Cap in Mon. Box
S14° W 36.30 Power Pole
N10° E 71.86' Light Pole
N34° W 98.58' 24" Twin Oak
N65° E 32.51' 1/2" rod in mon box

Lindgren witness
Porter witness
Lindgren witness
Lindgren witness

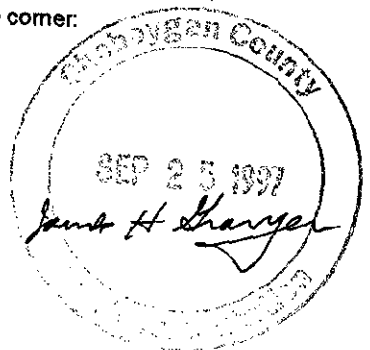

Signed by Ronald R. Bischer
Surveyor's Michigan License No. 22428

Date Oct. 10, 1997