

FEB 26 1998

LAND CORNER RECORDATION CERTIFICATE
Filing Requirement of Act 74, Mich. P.A. 1970

For corners in

CHEBOYGAN (County)	Located In:	Corner Code #
1. Public Land Survey	T ³⁵ N R ³ W	K-11
	T R	
	T R	
	T R	
2. Property Controlling in Section	S T R	
	S T R	
3. Miscellaneous Property in Sec.	S T R	
	S T R	

SECTION
12-22-97
RECEIVED FOR RECORD
at 9:13 O'Clock A M
Joanne Spray
CLERK/REGISTER
Register of Deeds Stamp & File Number

4. Lot No. _____, Recorded Plat _____
5. Private Claims _____

I, Ronald Bischer, in a field survey on Oct 9, 1997 do hereby state that under requirements of P.A. 74, Michigan P.A. of 1970, the corner points mentioned in lines 1 and 2 above were in conformance with regulations and rules therefore as required in the current manual of survey instructions of the United States Department of the Interior, Bureau of Land Management or by a decree of a Court of Law and/or that the corner points mentioned in lines 3, 4 and 5 above were in conformance with the rules of the Michigan Board of Land Surveyors or by a Decree of a Court of Law; established, re-established, monumented, recovered, found as expressed below:

NOTE: Not more than 2 corners, all in the same town and range, may be recorded on this certificate.

	A	B	C	D	E	F	G	H	I	J	K	L	M
1													
2	6		5		4		3		2		1		
3													
4	7		8		9		10		11		12		
5													
6	16		17		16		15		14		13		
7													
8	19		20		21		22		23		24		
9													
10	30		29		28		27		26		25		
11													
12	31		32		33		34		35		36		
13													

A. Description of original monument and accessories and/or subsequent restoration:

- K-11 1946 Joseph Doyle #3177 Found 1" Iron, set Conc. Mon. and 3 witnesses
- GLO Notes 1980 Delmer Porter #15410 found conc. mon. set 4 witnesses
- Harvey Mellen 1988 James Granger #16041 found conc. mon. set 4 witnesses
- 1855 Resurvey
- Set Post
- 12" Spruce pine S25° W 58 lks
- 9" Spruce Pine N20° E 1 lks

B. Description of corner evidence found and/or method applied in restoring or reestablishing corner:


- K-11 found conc. mon. and all four Granger witnesses
- Set Remon cap on Conc. Mon.



LIBER 011 PAGE 61

C. Description of monument for corner and accessories established to perpetuate locating the position of the corner:

- K-11 Remon Cap on Conc. Mon.
- N22° W 28.62' Power Pole Granger witness
- N73° W 93.50' 12" Norway Granger witness
- S50° W 75.66' 24" Norway Granger witness
- N68° E 64.19' Power pole Granger witness

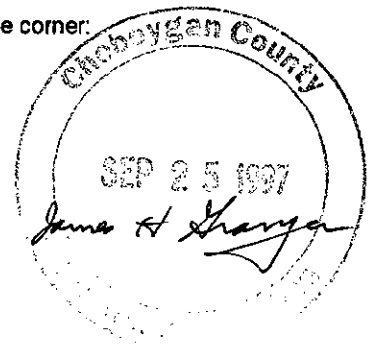

Signed by Ronald R. Bischer
Surveyor's Michigan License No. 22428

Date Oct. 10, 1997