

SURVEY & REMONUMENTATION

FEB 26 1998

1997 CHEBOYGAN COUNTY, STATE OF MICHIGAN REMONUMENTATION

LAND CORNER RECORDATION CERTIFICATE
Filing Requirement of Act 74, Mich. P.A. 1970

For corners in

<u>CHEBOYGAN</u> (County)	Located In:	Corner Code #
1. Public Land Survey	T <u>35</u> N <u>3</u> W	<u>K-13</u>
	T ___ R ___	_____
	T ___ R ___	_____
	T ___ R ___	_____
2. Property Controlling in Section	S ___ T ___ R ___	_____
	S ___ T ___ R ___	_____
3. Miscellaneous Property in Sec.	S ___ T ___ R ___	_____
	S ___ T ___ R ___	_____

SECTION 12-22-97
 RECEIVED FOR RECORD
 at 9:15 O'Clock A
Joanne Spray
 CLERK/REGISTER
 CHEBOYGAN COUNTY, MICHIGAN
 Register of Deeds Stamp & File Number

4. Lot No. _____, Recorded Plat _____
 5. Private Claims _____

I, Ronald Bischer, in a field survey on Oct 9, 1997 do hereby state that under requirements of P.A. 74, Michigan P.A. of 1970, the corner points mentioned in lines 1 and 2 above were in conformance with regulations and rules therefore as required in the current manual of survey instructions of the United States Department of the Interior, Bureau of Land Management or by a decree of a Court of Law and/or that the corner points mentioned in lines 3, 4 and 5 above were in conformance with the rules of the Michigan Board of Land Surveyors or by a Decree of a Court of Law; established, re-established, monumented, recovered, found as expressed below:

NOTE: Not more than 2 corners, all in the same town and range, may be recorded on this certificate.

A	B	C	D	E	F	G	H	I	J	K	L	M
1												
2	6		5		4		3		2		1	
3												
4	7		8		9		10		11		12	
5												
6	18		17		16		15		14		13	
7												
8	19		20		21		22		23		24	
9												
10	30		29		28		27		26		25	
11												
12	31		32		33		34		35		36	
13												

A. Description of original monument and accessories and/or subsequent restoration:

K-13
 GLO notes
 John Mullett
 1840 Original survey
 Set Post
 7" Pine N28° E 24 1 ks
 8" pine N36° W 23 1ks

1970 Orlando Doyle #7319
 Set conc mon and 1 witness



B. Description of corner evidence found and/or method applied in restoring or reestablishing corner:

K-13
 Found Conc. Mon.
 and 1 witness

Set Remon cap on conc. mon.


LIBER 011 PAGE 63

C. Description of monument for corner and accessories established to perpetuate locating the position of the corner:

K-13
 Remon cap on conc. mon.

 East 21.60' Conc. mon.
 N70° E 26.52' 18" Oak
 N21° E 51.93' 16" Oak
 S72° W 13.00' 17" Oak

Doyle witness

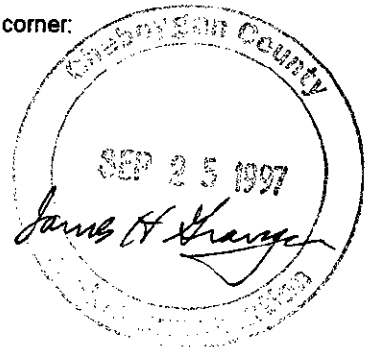

Signed by Ronald R. Bischer
 Surveyor's Michigan License No. 22428

Date Oct. 10, 1997