

FEB 26 1998

1997 CHEBOYGAN COUNTY, STATE OF MICHIGAN REMONUMENTATION

LAND CORNER RECORDATION CERTIFICATE
Filing Requirement of Act 74, Mich. P.A. 1970

SECTION

For corners in

CHEBOYGAN (County)

Located In:

Corner Code #

- 1. Public Land Survey T 35 N R 3 W L-7
2. Property Controlling in Section S T R
3. Miscellaneous Property in Sec. S T R

RECEIVED FOR RECORD at 9:18 O'Clock 12-22-97 A M

Signature of Joanne Spray

CLERK/REGISTER CHEBOYGAN COUNTY, MICHIGAN

Register of Deeds Stamp & File Number

- 4. Lot No. Recorded Plat
5. Private Claims

I, Ronald Bischer, in a field survey on Oct 8, 1997 do hereby state that under requirements of P.A. 74, Michigan P.A. of 1970, the corner points mentioned in lines 1 and 2 above were in conformance with regulations and rules therefore as required in the current manual of survey instructions of the United States Department of the Interior, Bureau of Land Management or by a decree of a Court of Law and/or that the corner points mentioned in lines 3, 4 and 5 above were in conformance with the rules of the Michigan Board of Land Surveyors or by a Decree of a Court of Law; established, re-established, monumented, recovered, found as expressed below:

NOTE: Not more than 2 corners, all in the same town and range, may be recorded on this certificate.


Grid table with columns A-M and rows 1-13. A dot is marked at row 7, column K.

A. Description of original monument and accessories and/or subsequent restoration:

- L-7 1982 Ronald Bischer #22428
GLO notes Found 4" Sq. conc. Mon. and 3 witnesses
Harvey Mellen 1988 Michael Trowbridge #27463
1855 Resurvey 4" Sq. Mon with 1" pipe and 4 witnesses
Set Post 1992 Norman Quaine #33984
14" White Oak N62° W 9 lks 4" Sq. Mon. with 1" pipe and 2 new witnesses
14" White Pine N73° E 33 lks

B. Description of corner evidence found and/or method applied in restoring or reestablishing corner:


- L-7 Found 4" Square conc. Mon. with 1" pipe and 3 Bischer witnesses and 4 Trowbridge witnesses and 4 Quaine witnesses Replaced with 5/8" Rod and Remon Cap

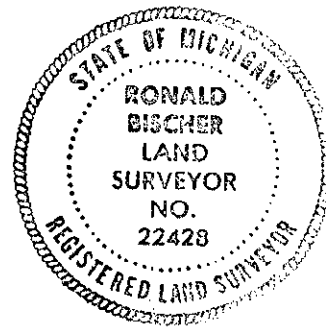

LIBER 011 PAGE 66

C. Description of monument for corner and accessories established to perpetuate locating the position of the corner:

- L-7 5/8" Rod and Remon Cap
N20° E 48.35' 24" Norway Bischer witness
N46° W 42.89' 13" White Pine Bischer witness
S77° E 3.89' 20" Maple Bischer witness
S07° E 21.70' 11" Fir Trowbridge witness
N58° E 19.29' 18" Norway Trowbridge witness

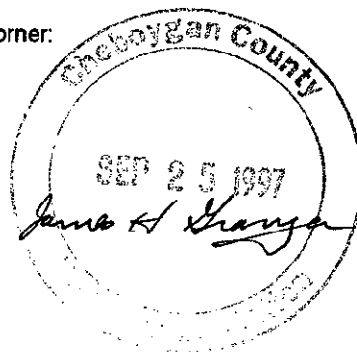

Signed by Ronald E. Bischer
Surveyor's Michigan License No. 22428

Date Oct. 10, 1997