

FEB 26 1998

1997 CHEBOYGAN COUNTY, STATE OF MICHIGAN REMONUMENTATION

LAND CORNER RECORDATION CERTIFICATE
Filing Requirement of Act 74, Mich. P.A. 1970

SECTION

For corners in

CHEBOYGAN (County)

Located In:

Corner Code #

- 1. Public Land Survey T 35 R 3W L-9
2. Property Controlling in Section S T R
3. Miscellaneous Property in Sec. S T R

RECEIVED FOR RECORD 12-22-97
at 9:19 O'Clock A M

Joanne Spray

CLERK/REGISTER
CHEBOYGAN COUNTY, MICHIGAN

Register of Deeds Stamp & File Number

4. Lot No. Recorded Plat
5. Private Claims

I, Ronald Bischer, in a field survey on Oct 8, 1997 do hereby state that under requirements of P.A. 74, Michigan P.A. of 1970, the corner points mentioned in lines 1 and 2 above were in conformance with regulations and rules therefore as required in the current manual of survey instructions of the United States Department of the Interior, Bureau of Land Management or by a decree of a Court of Law and/or that the corner points mentioned in lines 3, 4 and 5 above were in conformance with the rules of the Michigan Board of Land Surveyors or by a Decree of a Court of Law; established, re-established, monumented, recovered, found as expressed below:

NOTE: Not more than 2 corners, all in the same town and range, may be recorded on this certificate.

Grid table with columns A-M and rows 1-13. A dot is present at row 9, column L.

A. Description of original monument and accessories and/or subsequent restoration:

L-9
GLO Notes
Harvey Mellen
1855 Resurvey
Set Post
12" Yellow Pine S79 1/2 E 1.07 chains
4" Spruce Pine S70 1/2 W 29.1ks

1948 Joseph Doyle #3177
Found 1/2" pipe set conc. mon
and three witnesses
1976 Herbert Fluharty #18223
Found Conc. Mon. set 3 witnesses
1988 James Granger #16041
Found Conc. Mon. set 4 witnesses

B. Description of corner evidence found and/or method applied in restoring or reestablishing corner:

L-9
Found conc. mon.
and 2 Granger witnesses
Set Remon cap on Conc. Mon.




LIBER 011 PAGE 67

C. Description of monument for corner and accessories established to perpetuate locating the position of the corner:

L-9
Remon Cap on Concrete Monument
S61 W 39.35' Power Pole
N80 W 43.77' 10" Red Oak
S67 E 90.75' North Gate Post
N38 W 46.15' 5" Jack Pine

Granger witness
Granger witness

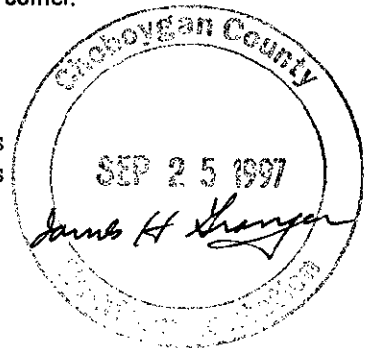

Signed by Ronald R. Bischer
Surveyor's Michigan License No. 22428

Date Oct. 10, 1997