

FEB 26 1998

1997 CHEBOYGAN COUNTY, STATE OF MICHIGAN REMONUMENTATION

LAND CORNER RECORDATION CERTIFICATE
Filing Requirement of Act 74, Mich. P.A. 1970

SECTION

For corners in

CHEBOYGAN
(County)

Located In:

Corner Code #

- | | | |
|------------------------------------|---------------------------|-------------|
| 1. Public Land Survey | T <u>35</u> N R <u>3W</u> | <u>L-11</u> |
| | T ___ R ___ | _____ |
| | T ___ R ___ | _____ |
| | T ___ R ___ | _____ |
| 2. Property Controlling in Section | S ___ T ___ R ___ | _____ |
| | S ___ T ___ R ___ | _____ |
| 3. Miscellaneous Property in Sec. | S ___ T ___ R ___ | _____ |
| | S ___ T ___ R ___ | _____ |

RECEIVED FOR RECORD
at 9:20 O'Clock A M

Joanne Gray

CLERK/REGISTER
CHEBOYGAN COUNTY, MICHIGAN

Register of Deeds Stamp & File Number

4. Lot No. _____, Recorded Plat _____
5. Private Claims _____

I, Ronald Bischer, in a field survey on Oct 9, 1997 do hereby state that under requirements of P.A. 74, Michigan P.A. of 1970, the corner points mentioned in lines 1 and 2 above were in conformance with regulations and rules therefore as required in the current manual of survey instructions of the United States Department of the Interior, Bureau of Land Management or by a decree of a Court of Law and/or that the corner points mentioned in lines 3, 4 and 5 above were in conformance with the rules of the Michigan Board of Land Surveyors or by a Decree of a Court of Law; established, re-established, monumented, recovered, found as expressed below:

NOTE: Not more than 2 corners, all in the same town and range, may be recorded on this certificate.

A	B	C	D	E	F	G	H	I	J	K	L	M
1												
2	6	5	4	3	2	1						
3												
4	7	8	9	10	11	12						
5												
6	18	17	16	15	14	13						
7												
8	19	20	21	22	23	24						
9												
10	30	29	28	27	26	25						
11												
12	31	32	33	34	35	36						
13												

A. Description of original monument and accessories and/or subsequent restoration:

L-11
GLO Notes
Harvey Mellen
Set Post 1855 Resurvey
16" Yellow Pine N87° E 24 lks
16" Yellow Pine S36° W 19 lks

1946 Joseph Doyle #3177
Set 1" Axle shaft and 3 witnesses
1988 James Granger #16041
Found 1/2" pipe set 4 witnesses

B. Description of corner evidence found and/or method applied in restoring or reestablishing corner:

L-11
Found 3/4" pipe
and 3 Granger witnesses
Replaced with 5/8" rod and remon cap




LIBER 011 PAGE 68

C. Description of monument for corner and accessories established to perpetuate locating the position of the corner:

L-11
5/8" rod and remon cap
N68° W 50.06' Power Pole
N25° E 43.78' 32" Oak
S28° E 50.10' 7" Jack Pine
S15° W 53.24' 8" Jack Pine

Granger witness
Granger witness
Granger witness

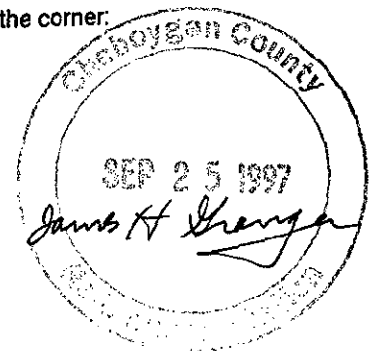

Signed by Ronald R. Bischer
Surveyor's Michigan License No. 22428

Date Oct. 10, 1997