

**SURVEY &
MONUMENTATION**

JAN 23 1996

**CHEBOYGAN COUNTY REMONUMENTATION CORNER
LAND CORNER RECORDATION CERTIFICATE
Filing Requirement of Act 74, Mich. P.A. 1970**

For corners in **COMMISSION**
CHEBOYGAN
(County)

Located In: Corner Code #

- | | | | | | |
|---|---|-----|---|----|-----|
| 1. Public Land Survey | T | 35N | R | 3W | M-2 |
| | T | | R | | |
| | T | | R | | |
| | T | | R | | |
| 2. Property Controlling
in Section | S | | T | R | |
| | S | | T | R | |
| 3. Miscellaneous
Property in Section | S | | T | R | |
| | S | | T | R | |

4. Lot No. _____, Recorded Plat _____
5. Private Claims _____

RECEIVED
FOR RECORD
95 DEC 26 PM 2:27
Joanne Spray
CLERK/REGISTER
CHEBOYGAN COUNTY, MICHIGAN
Register of Deeds Stamp & File Number

I, RICHARD C. DUNN, in a field survey on AUGUST, 1995, do hereby certify that under requirements of P.A. 74, Michigan P.A. of 1970, the corner points mentioned in lines 1 and 2 above were in conformance with regulations and rules therefore as required in the current manual of survey instructions of the United States Department of the Interior, Bureau of Land Management or by a decree of a Court of Law and/or that the corner points mentioned in lines 3, 4 and 5 above were in conformance with the rules of the Michigan Board of Professional Surveyors or by a Decree of a Court of Law; established, re-established, monumented, re-monumented, recovered, found as expressed below:

NOTE: Not more than 4 corners, all in the same town and range, may be recorded on this certificate.

A	B	C	D	E	F	G	H	I	J	K	L	M
2	6	5	4	3	2	1						
3												
4	7	8	9	10	11	12						
5												
6	18	17	16	15	14	13						
7												
8	19	20	21	22	23	24						
9												
10	30	29	28	27	26	25						
11												
12	31	32	33	34	35	36						
13												

A. Description of original monument and accessories and/or subsequent restoration:


G.L.O. John Mullett 1840
Set 1/4 Sec. Post
9" Tamarack S53°W 10 Links
7" Cedar N38°W 10 Links

Dean Delamater #5778
March 1961
Fnd. 3/4" Iron Pipe
8" Balsam S06°E 48.50'
6" Balsam N07°E 86.02'
10" Balsam N13°E 44.95'
20.8' E of C/L US 27

Clifford Lindgren #14098
April 1991
Fnd. RR spike 11.3' E of Sta. 139 + 79.3 as shown on Hwy. Plans. Corner was witnessed before road cons't. in 1990. Corner was removed during cons't. and new Mon. box was set on Nov. 14, 1990.
Set 1/2" re-rod w/cap #14098
PK w/Cap in S. End 24" CMP S65°W 61.18'

B. Description of corner evidence found and/or method applied in restoring or reestablishing corner:

Found 1/2" bar w/Cap #14098 in Monument Box.

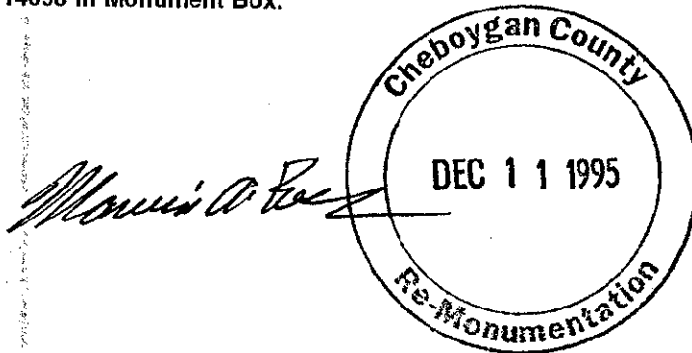

C. Description of monument for corner and accessories established to perpetuate locating the position of the corner:

M-2 Found 1/2" bar per Liber 002, page 132, Cheboygan County Records and is accepted as a careful and faithful reestablishment of the position of the original corner. Replaced 1/2" bar and cap with 5/8" rebar and remonumentation cap at accepted position.

PK w/Cap S. End 24" CMP	S65°W	61.18'
PK w/Cap N. End 24" CMP	S80°W	46.29'
5" Maple Set 60 P	N85°W	67.25'
W. Leg of sign post Set PK	S7°E	178.45'
10.9' East of C/L US 27		

LIBER 010 PAGE 134

Signed by Richard C. Dunn

Date DECEMBER 4, 1995

Surveyor's Michigan License No. 12020