

**SURVEY &  
REMONUMENTATION**

CHEBOYGAN COUNTY REMONUMENTATION CORNER

**LAND CORNER RECORDATION CERTIFICATE**

JAN 23 1996

Filing Requirement of Act 74, Mich. P.A. 1970

For corners in CHEBOYGAN COMMISSION Located In: \_\_\_\_\_  
(County)

Corner Code # \_\_\_\_\_

- |   |                          |            |
|---|--------------------------|------------|
| 1. Public Land Survey                   | T <u>35N</u> R <u>3W</u> | <u>M-4</u> |
|   | T _____ R _____          | _____      |
|   | T _____ R _____          | _____      |
|   | T _____ R _____          | _____      |
| 2. Property Controlling<br>in Section   | S _____ T _____ R _____  | _____      |
|   | S _____ T _____ R _____  | _____      |
| 3. Miscellaneous<br>Property in Section | S _____ T _____ R _____  | _____      |
|   | S _____ T _____ R _____  | _____      |
| 4. Lot No. _____, Recorded Plat _____   |                          |            |
| 5. Private Claims _____                 |                          |            |

RECEIVED  
FOR RECORD  
95 DEC 26 PM 2:29

*James Granger*  
CLERK/REGISTER  
CHEBOYGAN COUNTY, MICHIGAN

Register of Deeds Stamp & File Number

A	B	C	D	E	F	G	H	I	J	K	L	M
2	6	5	4	3	2	1						
3												
4	7	8	9	10	11	12						
5												
6	18	17	16	15	14	13						
7												
8	19	20	21	22	23	24						
9												
10	30	29	28	27	26	25						
11												
12	31	32	33	34	35	36						
13												

I, RICHARD C. DUNN, in a field survey on AUGUST, 19 95, do hereby certify that under requirements of P.A. 74, Michigan P.A. of 1970, the corner points mentioned in lines 1 and 2 above were in conformance with regulations and rules therefore as required in the current manual of survey instructions of the United States Department of the Interior, Bureau of Land Management or by a decree of a Court of Law and/or that the corner points mentioned in lines 3, 4 and 5 above were in conformance with the rules of the Michigan Board of Professional Surveyors or by a Decree of a Court of Law; established, re-established, monumented, re-monumented, recovered, found as expressed below:

**NOTE: Not more than 4 corners, all in the same town and range, may be recorded on this certificate.**

**A. Description of original monument and accessories and/or subsequent restoration:**



G.L.O. John Mullett 1840  
Set 1/4" Section Post  
9" W Oak S79°W 19 Links  
6" W Oak N12°E 20 Links

Orlando Doyle #7319  
May 1955  
Set 1" Pipe  
8" Oak N50°30'W 59.89'  
10" Oak S84°30'W 83.95'  
SE Cor. of Culvert N11°E 83.62'  
E. Edge of Pvt. West 2.65'

James Granger #16041  
Nov. 1987  
Fnd. Con. Mon.  
P. Pole N30°W 76.94'  
16" Tw. Hickory N49°W 59.79'  
12" Tw. Hickory S87°W 83.44'  
Fence Post S86°E 81.63'

**B. Description of corner evidence found and/or method applied in restoring or reestablishing corner:**

Found Concrete Monument w/5/8" Bar in Monument Box.

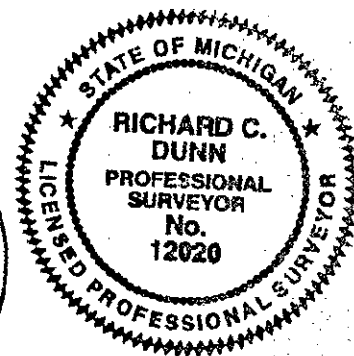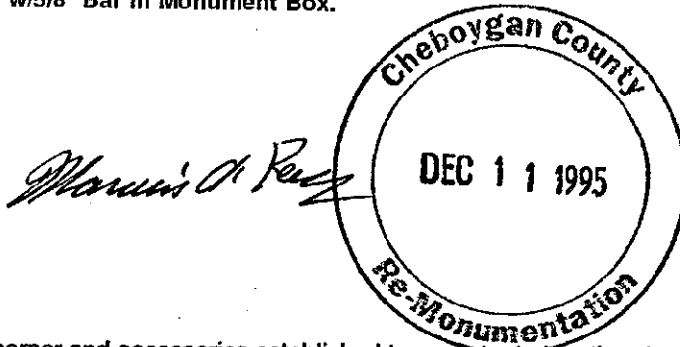

**C. Description of monument for corner and accessories established to perpetuate locating the position of the corner:**

M-4 Found Con. Mon. w/5/8" Bar in Monument Box and is accepted as a careful and faithful reestablishment of the position of the original corner. Placed remonumentation cap on accepted monument.

P. Pole w/Tag #10710	N33°W	76.94'
20" Oak w/Tag #15410	N51°W	59.70'
18" Oak w/Tag #10710	S86°W	83.26'
6" W. Pine, Set PK	N82°E	32.88'
C/L U.S. 27	West	13.15'

LIBER **010** PAGE **136**

Signed by *Richard C. Dunn*

Date DECEMBER 4, 1995

Surveyor's Michigan License No. 12020