

SURVEY & MONUMENTATION

JAN 23 1996

**CHEBOYGAN COUNTY REMONUMENTATION CORNER
LAND CORNER RECORDATION CERTIFICATE
Filing Requirement of Act 74, Mich. P.A. 1970**

For corners in **CHEBOYGAN** COMMISSION
(County)

Located In: Corner Code #

1. Public Land Survey	T	35N	R	3W	M-6
	T		R		
	T		R		
	T		R		
2. Property Controlling in Section	S		T	R	
	S		T	R	
3. Miscellaneous	S		T	R	
Property in Section	S		T	R	

RECEIVED FOR RECORD
95 DEC 26 PM 2:32

Joanna Spray
CLERK/REGISTER
CHEBOYGAN COUNTY, MICHIGAN

Register of Deeds Stamp & File Number

4. Lot No. _____, Recorded Plat _____
5. Private Claims _____

A	B	C	D	E	F	G	H	I	J	K	L	M
2	6	5	4	3	2							
3												
4	7	8	9	10	11	12						
5												
6	18	17	16	15	14	13						
7												
8	19	20	21	22	23	24						
9												
10	30	29	28	27	26	25						
11												
12	31	32	33	34	35	36						
13												

I, RICHARD C. DUNN, in a field survey on AUGUST, 19 95, do hereby certify that under requirements of P.A. 74, Michigan P.A. of 1970, the corner points mentioned in lines 1 and 2 above were in conformance with regulations and rules therefore as required in the current manual of survey instructions of the United States Department of the Interior, Bureau of Land Management or by a decree of a Court of Law and/or that the corner points mentioned in lines 3, 4 and 5 above were in conformance with the rules of the Michigan Board of Professional Surveyors or by a Decree of a Court of Law; established, re-established, monumented, re-monumented, recovered, found as expressed below:

NOTE: Not more than 4 corners, all in the same town and range, may be recorded on this certificate.

A. Description of original monument and accessories and/or subsequent restoration:


G.L.O. John Mullett 1840
Set 1/4 Section Post
8" Hemlock S76°W 6 Links
9" Cedar N4°W 9 Links

Orlando Doyle #7319
May 1953
Fnd. 1" Iron Shaft
18" W Pine S73°30'E 52.21'
12" W Pine N37°E 61.44'
E. Edge of Pvt. West 14.19'

Ronald Bisher #22428
Oct. 1982
Fnd. 1" Bar
18" W Pine N37°E 61.44'
24" W Pine S73°E 52.14'
P.Pole N77°W 57.70'

B. Description of corner evidence found and/or method applied in restoring or reestablishing corner:

Found 1" Bar (at toe of slope).

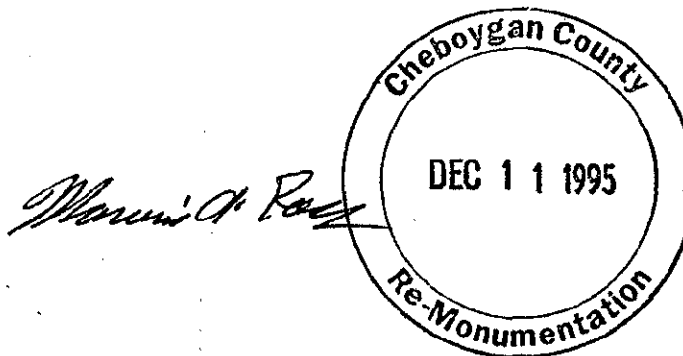

C. Description of monument for corner and accessories established to perpetuate locating the position of the corner:

M-6	Found 1" Bar per Liber 001, page 303, Cheboygan County Records and is accepted as a careful and faithful reestablishment of the position of the original corner. Re-placed w/5/8" re-rod and remonumentation cap.		
	18" W Pine Set PK	N37°E	61.60'
	24" W Pine w/MSHD tag	S75°E	52.10'
	Light Pole w/tag 15410	N79°W	57.50'
	21" W Pine Set PK	S37°W	161.45'
	C/L U.S. 27	West	23.8'

LIBER 010 PAGE 138

Signed by *Richard C. Dunn*

Date DECEMBER 4, 1995

Surveyor's Michigan License No. 12020