

JAN 23 1996 CHEBOYGAN COUNTY REMONUMENTATION CORNER

LAND CORNER RECORDATION CERTIFICATE

COMMISSION

Filing Requirement of Act 74, Mich. P.A. 1970

For corners in

CHEBOYGAN

(County)

Located In:

Corner Code #

- 1. Public Land Survey T 35N R 3W M-7
- T R _____
- T R _____
- T R _____
- T R _____
- 2. Property Controlling S T R _____
- in Section S T R _____
- 3. Miscellaneous S T R _____
- Property In Section S T R _____

RECEIVED FOR RECORD

95 DEC 26 PM 2: 34

James Gray

CLERK/REGISTER CHEBOYGAN COUNTY, MICHIGAN

Register of Deeds Stamp & File Number

- 4. Lot No. _____, Recorded Plat _____
- 5. Private Claims _____

I, RICHARD C. DUNN, in a field survey on AUGUST, 19 95, do hereby certify that under requirements of P.A. 74, Michigan P.A. of 1970, the corner points mentioned in lines 1 and 2 above were in conformance with regulations and rules therefore as required in the current manual of survey instructions of the United States Department of the Interior, Bureau of Land Management or by a decree of a Court of Law and/or that the corner points mentioned in lines 3, 4 and 5 above were in conformance with the rules of the Michigan Board of Professional Surveyors or by a Decree of a Court of Law; established, re-established, monumented, re-monumented, recovered, found as expressed below:

A	B	C	D	E	F	G	H	I	J	K	L	M
2	6	5	4	3	2							
3												
4	7	8	9	10	11	12						
5												
6	18	17	16	15	14	13						
7												
8	19	20	21	22	23	24						
9												
10	30	29	28	27	26	25						
11												
12	31	32	33	34	35	36						
13												

NOTE: Not more than 4 corners, all in the same town and range, may be recorded on this certificate.

A. Description of original monument and accessories and/or subsequent restoration:

G.L.O. John Mullett 1840
Set Post Cor. Secs. 13 & 24
7" Aspen S10°W 17 Links
5" Aspen N13°W 16 Links

Dean Delamater #5778
Mar. 1961
Fnd. 3/4" Iron Pipe
P.Pole S37°E 37.05'
SE Cor. Garage N82°W 78.00'
Apple Tree S43°W 39.70'
Apple Tree N40°E 28.70'

Ronald Bisher #22428
Oct. 1982
Fnd. 1/2" Pipe
SE Cor. Garage N82°W 78.00'
Apple Tree N62°E 54.13'
P.Pole S37°E 36.53'

B. Description of corner evidence found and/or method applied in restoring or reestablishing corner:

Norman Quaine #33984
July 1992
Fnd. 1/2" Pipe in Mon. Box
SE cor. Garage N82°W 78.00'
5" Apple Tree N62°E 54.13'
SW Cor. House N68°E 83.81'
P.Pole S33°E 38.90'

Norman Quaine #33984
June 1994
Fnd. 1/2" Pipe in Mon. Box in
Road Centerline
24" Ash N37°E 61.25'
L. Pole S35°E 36.50'
6" Apple Tree N63°E 53.40"
SE Cor. Garage N83°W 77.89'

Found 1/2" Pipe in Monument Box.


LIBER 010 PAGE 139



C. Description of monument for corner and accessories established to perpetuate locating the position of the corner:

M-7 Found 1/2" Pipe in Monument Box and is accepted as a careful and faithful reestablishment of the position of the original corner. Placed 5/8" re-rod and remonumentation cap inside pipe at accepted position.

P. Pole w/tag 15410	S36°E	39.00'
SE Cor. Garage	N83°W	78.05'
5" Tri. Apple w/tag 15410	N57°E	53.76'
15" Tw. Box Elder Set PK	N49°W	81.73'

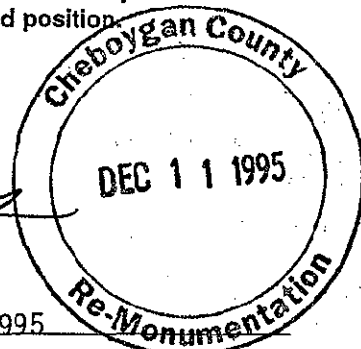

Signed by *Richard C. Dunn*

Date DECEMBER 4, 1995

Surveyor's Michigan License No. 12020