

JAN 23 1996 CHEBOYGAN COUNTY REMONUMENTATION CORNER
COMMISSION LAND CORNER RECORDATION CERTIFICATE
Filing Requirement of Act 74, Mich. P.A. 1970

For corners in
CHEBOYGAN
(County)

Located In:

Corner Code #

1. Public Land Survey	T	<u>35N</u>	R	<u>3W</u>	<u>M-9</u>
	T	_____	R	_____	_____
	T	_____	R	_____	_____
	T	_____	R	_____	_____
2. Property Controlling in Section	S	_____	T	_____	_____
	S	_____	T	_____	_____
3. Miscellaneous Property in Section	S	_____	T	_____	_____
	S	_____	T	_____	_____

RECEIVED
FOR RECORD

95 DEC 26 PM 2:38

James Gray

CLERK/REGISTER
CHEBOYGAN COUNTY, MICHIGAN

Register of Deeds Stamp & File Number

4. Lot No. _____, Recorded Plat _____
5. Private Claims _____

A	B	C	D	E	F	G	H	I	J	K	L	M
2	6	5	4	3	2							
3												
4	7	8	9	10	11	12						
5												
6	18	17	16	15	14	13						
7												
8	19	20	21	22	23	24						
9												
10	30	29	28	27	26	25						
11												
12	31	32	33	34	35	36						
13												

I, RICHARD C. DUNN, in a field survey on AUGUST, 19 95, do hereby certify that under requirements of P.A. 74, Michigan P.A. of 1970, the corner points mentioned in lines 1 and 2 above were in conformance with regulations and rules therefore as required in the current manual of survey instructions of the United States Department of the Interior, Bureau of Land Management or by a decree of a Court of Law and/or that the corner points mentioned in lines 3, 4 and 5 above were in conformance with the rules of the Michigan Board of Professional Surveyors or by a Decree of a Court of Law; established, re-established, monumented, re-monumented, recovered, found as expressed below:

NOTE: Not more than 4 corners, all in the same town and range, may be recorded on this certificate.

A. Description of original monument and accessories and/or subsequent restoration:


G.L.O. John Mullett 1840
Set Post Cor. Secs. 24 & 25
10" Fir S35°W 17 Links
9" Fir S70°E 17 Links

Dean Delamater #5778
April 1960
Fnd. 1/2" Iron in Con. Mon
5" W Birch N66°E 32.09'
4" Oak N14°E 43.80'
4" Maple S31°E 34.38'

B. Description of corner evidence found and/or method applied in restoring or reestablishing corner:

Found Concrete Monument.

Morris A. Bass

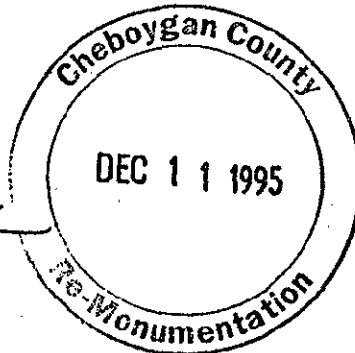

C. Description of monument for corner and accessories established to perpetuate locating the position of the corner:

M-9	Found Concrete Monument and is accepted as a careful and faithful reestablishment of the position of the original corner. Placed remonumentation cap on accepted monument.		
	7" Basswood w/tag 15410	S26°E	34.45'
	14" Spruce w/60 P	N33°W	21.85'
	14" Spruce w/60 P	N18°E	39.29'
	7" Elm w/60P	N56°E	32.03'

LIBER 010 PAGE 141

Signed by *Richard C. Dunn*

Date DECEMBER 4, 1995

Surveyor's Michigan License No. 12020