

JAN 23 1996 CHEBOYGAN COUNTY REMONUMENTATION CORNER LAND CORNER RECORDATION CERTIFICATE

COMMISSION

Filing Requirement of Act 74, Mich. P.A. 1970

For corners in CHEBOYGAN (County)

Located In:

Corner Code #

Table with 3 columns: Item description, T/S, R/W, and Corner Code #. Includes items like Public Land Survey, Property Controlling in Section, and Miscellaneous Property in Section.

RECEIVED FOR RECORD

95 DEC 26 PM 2:41

James Granger, CLERK/REGISTER CHEBOYGAN COUNTY, MICHIGAN

Register of Deeds Stamp & File Number

4. Lot No. , Recorded Plat
5. Private Claims

I, RICHARD C. DUNN, in a field survey on AUGUST, 19 95, do hereby certify that under requirements of P.A. 74, Michigan P.A. of 1970, the corner points mentioned in lines 1 and 2 above were in conformance with regulations and rules therefore as required in the current manual of survey instructions of the United States Department of the Interior, Bureau of Land Management or by a decree of a Court of Law and/or that the corner points mentioned in lines 3, 4 and 5 above were in conformance with the rules of the Michigan Board of Professional Surveyors or by a Decree of a Court of Law; established, re-established, monumented, re-monumented, recovered, found as expressed below:

NOTE: Not more than 4 corners, all in the same town and range, may be recorded on this certificate.

Grid table with columns A-M and rows 2-13, containing numbers 1-36.

A. Description of original monument and accessories and/or subsequent restoration:

G.L.O. John Mullett 1840
18" Pine S30°W 5.30 Links
3" Aspen N69°E 68 Links



Dean Delamater #5778
April 1960
Fnd. 1/4"x1 1/2" Iron Bar
4" N Pine S62°E 52.10'
4" Maple N78°E 37.90'
10" Oak N03°W 46.52'

George Young #10710
Sep't. 1972
Fnd. 5/8" Iron Bar
Old fence lines North, South and East.
6" Maple South 27.04'
8" Maple N80°E 37.65'
15" Oak N05°W 45.63'

B. Description of corner evidence found and/or method applied in restoring or reestablishing corner:

James Granger #16041
Dec. 1990
Fnd. 5/8" Iron Bar
P.Pole N22°W 28.45'
P.Pole N70°E 64.19'
8" R Pine N73°W 93.28'
8" R Pine S53°W 75.66'
Found 1/4" x 1 1/2" Iron Bar next to 5/8" Iron Bolt.

Marvin A. Raus

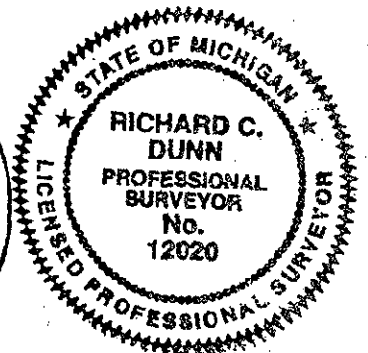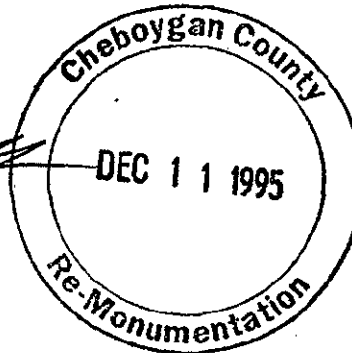

C. Description of monument for corner and accessories established to perpetuate locating the position of the corner:

Table with 3 columns: Item description, Angle, and Distance. Includes items like Found 1/4" x 1 1/2" Iron Bar next to 5/8" Iron Bolt, 21" Oak w/tag 10710, 6" Maple, Set PK, 8" Quad Maple, Set PK, 10" R Pine, Set PK, C/L Club Road.

LIBER 010 PAGE 143

Signed by Richard C. Dunn

Date DECEMBER 4, 1995

Surveyor's Michigan License No. 12020