

JAN 23 1996 CHEBOYGAN COUNTY REMONUMENTATION CORNER LAND CORNER RECORDATION CERTIFICATE

COMMISSION Filing Requirement of Act 74, Mich. P.A. 1970

For corners in CHEBOYGAN (County) Located In: Corner Code #
1. Public Land Survey T 35N R 3W M-12
2. Property Controlling in Section S T R
3. Miscellaneous Property In Section S T R

RECEIVED FOR RECORD 95 DEC 26 PM 2:42
Joanna Spray
CLERK/REGISTER CHEBOYGAN COUNTY, MICHIGAN
Register of Deeds Stamp & File Number

4. Lot No. , Recorded Plat
5. Private Claims

Grid table with columns A-M and rows 2-13. Contains numbers 6 through 36.

I, RICHARD C. DUNN, in a field survey on AUGUST, 19 95, do hereby certify that under requirements of P.A. 74, Michigan P.A. of 1970, the corner points mentioned in lines 1 and 2 above were in conformance with regulations and rules therefore as required in the current manual of survey instructions of the United States Department of the Interior, Bureau of Land Management or by a decree of a Court of Law and/or that the corner points mentioned in lines 3, 4 and 5 above were in conformance with the rules of the Michigan Board of Professional Surveyors or by a Decree of a Court of Law; established, re-established, monumented, re-monumented, recovered, found as expressed below:

NOTE: Not more than 4 corners, all in the same town and range, may be recorded on this certificate.



A. Description of original monument and accessories and/or subsequent restoration:

- G.L.O. John Mullett 1840 Set 1/4 Section Post 10" Pine S27°W 85 Links 16" Pine S68°E 79 Links
George Young #10710 Sep't. 1972 Fnd. Con. Monument 6" Maple S65°W 37.90' 10" Aspen S20°E 6.40' 4" Maple N35°E 7.62'

B. Description of corner evidence found and/or method applied in restoring or reestablishing corner:

Found Concrete Monument.

Handwritten signature: Marvin A. Ross

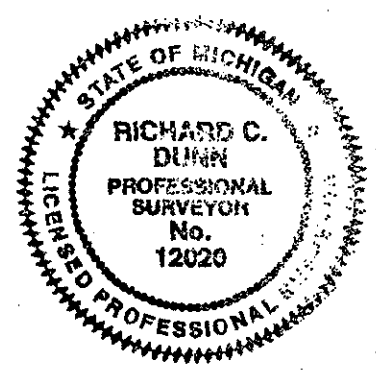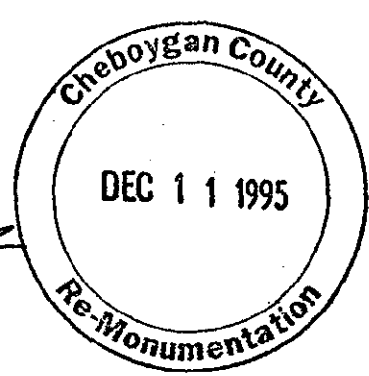

C. Description of monument for corner and accessories established to perpetuate locating the position of the corner:

- M12 Found Concrete Monument and is accepted as a careful and faithful reestablishment of the position of the original corner. Placed remonumentation cap on accepted corner.
4" Tw. Maple w/tag 10710 N35°E 7.80'
5" Maple Clump, Set PK S13°E 29.84'
10" Tw. Maple, Set PK S58°W 38.04'
4" Tw. Maple, Set PK N80°W 24.44'
C/L Club Road East 125' +/-

LIBER 010 PAGE 144

Signed by [Signature] Date DECEMBER 4, 1995
Surveyor's Michigan License No. 12020