

JAN 23 1996

CHEBOYGAN COUNTY REMONUMENTATION CORNER  
LAND CORNER RECORDATION CERTIFICATE  
Filing Requirement of Act 74, Mich. P.A. 1970

For corners in **COMMISSION**  
**CHEBOYGAN**  
(County)

Located In: Corner Code #

1. Public Land Survey	T	35N	R	3W	M-13
	T		R		
	T		R		
	T		R		
2. Property Controlling in Section	S		T	R	
	S		T	R	
3. Miscellaneous Property in Section	S		T	R	
	S		T	R	

RECEIVED FOR RECORD  
95 DEC 26 PM 2:43

*James Spring*  
CLERK/REGISTER  
CHEBOYGAN COUNTY, MICHIGAN

Register of Deeds Stamp & File Number:

4. Lot No. \_\_\_\_\_, Recorded Plat \_\_\_\_\_  
5. Private Claims \_\_\_\_\_

I, RICHARD C. DUNN, in a field survey on AUGUST, 19 95, do hereby certify that under requirements of P.A. 74, Michigan P.A. of 1970, the corner points mentioned in lines 1 and 2 above were in conformance with regulations and rules therefore as required in the current manual of survey instructions of the United States Department of the Interior, Bureau of Land Management or by a decree of a Court of Law and/or that the corner points mentioned in lines 3, 4 and 5 above were in conformance with the rules of the Michigan Board of Professional Surveyors or by a Decree of a Court of Law; established, re-established, monumented, re-monumented, recovered, found as expressed below:

A	B	C	D	E	F	G	H	I	J	K	L	M
2	6	5	4	3	2	1						
3												
4	7	6	9	10	11	12						
5												
6	18	17	16	15	14	13						
7												
8	19	20	21	22	23	24						
9												
10	30	29	28	27	26	25						
11												
12	31	32	33	34	35	36						
13												

NOTE: Not more than 4 corners, all in the same town and range, may be recorded on this certificate.


A. Description of original monument and accessories and/or subsequent restoration:

- |   |   |
|---|---|
| G.L.O. John Mullett 1840<br>Set Post for Twp. Corner<br>10" Birch N41°W 9 Links<br>10" Beech S45°E 29 Links | George Young #10710<br>Sep't. 1972<br>Fnd. 1 1/4" Iron Bar<br>6" Maple S30°W 20.60'<br>8" R Pine N88°W 46.46'<br>10" Oak S80°E 53.75' |
|---|---|

B. Description of corner evidence found and/or method applied in restoring or reestablishing corner:

Found 1 1/4" Axle Shaft.

*Marvin A. [Signature]*

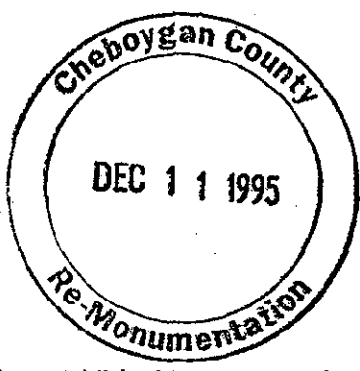

C. Description of monument for corner and accessories established to perpetuate locating the position of the corner:

- M-13 Found 1 1/4" Axle Shaft and is accepted as a careful and faithful reestablishment of the position of the original corner. Placed 5/8" re-rod and remonumentation cap at accepted position.
- |                        |       |         |
|------------------------|-------|---------|
| 8" J Pine w/tag 10710  | N88°W | 46.43'  |
| 30" R Pine w/tag 15410 | N55°W | 34.02'  |
| 8" Maple Clump, Set PK | S27°W | 20.90'  |
| 5" R Pine, Set PK      | N75°E | 11.10'  |
| C/L Club Road          | South | 50' +/- |

LIBER 010 PAGE 145

Signed by *Richard C. Dunn*

Date DECEMBER 4, 1995

Surveyor's Michigan License No. 12020