

MICHIGAN
DEPARTMENT OF CONSERVATION
FORESTRY DIVISION

LAND CORNER RECORD

T. 35N N.R. 3W


Cheboygan COUNTY

DESCRIPTION OF CORNER Section corner common to Sections 33 and 34 on South boundary
of township.

CORNER MONUMENT 1" pipe with 4" brass cap

DATE MONUMENT PLACED AND WITNESSED May 31, 1961

WITNESSES TO CORNER.....

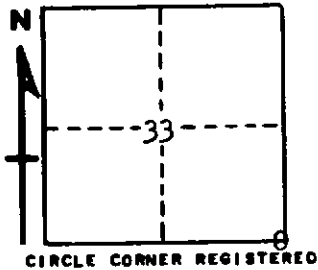

5" R. Pine N 47 W 34.3 ft.

7" W. Pine N 27 E 23.0 ft.

AND

DESCRIPTION IN DETAIL AS TO HOW CORNER WAS LOCATED AND IDENTIFIED OR RESTORED.

This corner was established by single proportionate measurement between section corners 1 mile west and 1 mile east by Forestry Division survey crew while making a survey in this area. Unable to identify government B. T.'s. Corner to Sections 3 and 4, T34N, R3W is 90 links east.

SURVEYOR'S SEAL

SIGNED Kenneth J. Betting DATE June 6, 1961
REGISTERED LAND SURVEYOR