

MAR 22 1999

1998 CHEBOYGAN COUNTY, STATE OF MICHIGAN REMONUMENTATION

SECTION

LAND CORNER RECORDATION CERTIFICATE
Filing Requirement of Act 74, Mich. P.A. 1970

For corners in

Cheboygan Located in: Corner Code #
(County)
Forest Township
1. Public Land Survey
Waverly Township
T34NR 1E D-1
T35NR 1E D-13 ✓
T R
T R
S T R
S T R
S T R
S T R
2. Property Controlling in Section
3. Miscellaneous Property in Sec.
4. Lot No. _____, Recorded Plat _____
5. Private Claims _____

RECEIVED FOR RECORD 12-7-98
at 9:32 O'Clock A M
James Gray
CLERK/REGISTER
CHEBOYGAN COUNTY, MICHIGAN
Register of Deeds Stamp & File Number

	A	B	C	D	E	F	G	H	I	J	K	L	M
1													
2	6		5		4		3		2		1		
3													
4	7		8		9		10		11		12		
5													
6	18		17		16		15		14		13		
7													
8	19		20		21		22		23		24		
9													
10	30		29		28		27		26		25		
11													
12	31		32		33		34		35		36		
13													

I, Ronald Bischer, in a field survey on 7-14, 1998 do hereby state that under requirements of P.A. 74, Michigan P.A. of 1970, the corner points mentioned in lines 1 and 2 above were in conformance with regulations and rules therefore as required in the current manual of survey instructions of the United States Department of the Interior, Bureau of Land Management or by a decree of a Court of Law and /or that the corner points mentioned in lines 3, 4 and 5 above were in conformance with the rules of the Michigan Board of Land Surveyors or by a Decree of a Court of Law; established, re-established, monumented, recovered, found as expressed below:

NOTE: Not more than 2 corners, all in the same town and range, may be recorded on this certificate.


A. Description of original monument and accessories and/or subsequent restoration:

D-1
1840 John Hodgson
1855 Resurvey by George Cannon
GLO Notes
June 7, 1972 Delmer Porter #15410
Found 1 1/2" rod and three witnesses
Sept. 13, 1972 Delmer Porter #15410
Found 1 1/4" rod and 3 witnesses

Oct. 9, 1973 Delmer Porter #15410
found 1 1/4" rod and 3 witnesses
June 23 1976 Delmer Porter #15410
found 1 1/4" rod and 3 witnesses
June 15, 1978 Delmer Porter #15410
Found 1 1/4" rod and 3 witnesses


B. Description of corner evidence found and/or method applied in restoring or reestablishing corner:

D-1
Found 1 1/4" rod
replaced with 5/8" rod and remon cap

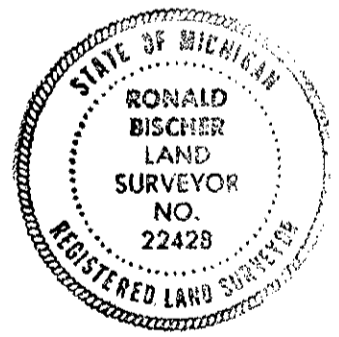

C. Description of monument for corner and accessories established to perpetuate locating the position of the corner:

D-1
5/8" rod and remon cap
N08° E 33.70' Fence cor. O.W.
S20° W 34.44' 9" Red Pine
S46° W 42.30' 9" White Pine
N59° E 54.91' 4" Cherry

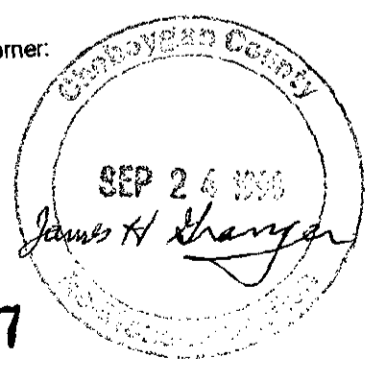

LIBER 011 PAGE 97

Signed by Ronald R. Bischer
Surveyor's Michigan License No. 22428

Date Sept. 28, 1998