

RECEIVED
FOR RECORD

99 DEC 27 PM 3:45

LAND CORNER RECORDATION CERTIFICATE
Filing Requirement of Act 74, Mich. P.A. 1970

For corners in

Cheboygan Located In: Corner Code #
(County)

- 1. Public Land Survey T 34R 1E J-1
~~T 35R 1E~~ J-13
T ___ R ___
T ___ R ___
- 2. Property Controlling S ___ T ___ R ___
in Section S ___ T ___ R ___
- 3. Miscellaneous S ___ T ___ R ___
Property in Sec. S ___ T ___ R ___

4. Lot No. _____, Recorded Plat _____
5. Private Claims _____

I, Ronald Bischer, in a field survey on Aug 10, 1999 do hereby state that under requirements of P.A. 74, Michigan P.A. of 1970, the corner points mentioned in lines 1 and 2 above were in conformance with regulations and rules therefore as required in the current manual of survey instructions of the United States Department of the Interior, Bureau of Land Management or by a decree of a Court of Law and/or that the corner points mentioned in lines 3, 4 and 5 above were in conformance with the rules of the Michigan Board of Land Surveyors or by a Decree of a Court of Law; established, re-established, monumented, recovered, found as expressed below:

NOTE: Not more than 2 corners, all in the same town and range, may be recorded on this certificate.

A. Description of original monument and accessories and/or subsequent restoration:

J-1
1840 GLO Notes
N17°W 12 lks 24" Sugar
N51°E 31 lks 12" Sugar
Nov. 20, 1922 David Bowen
4" Sq. cedar post with light T-rail
driven along side of post on stone ridge

Dec. 20, 1993 Ronald Bischer #2242
set 1/2" rod @ very old fence corner
S13°W 21.60' 9" Maple
N22°W 32.98' 6" Ironwood
N27°E 68.85' 18" Cedar
N31°E 32.36' 7" Maple
July 5, 1994 Norman Quaine #33984
1/2" rod and cap and 4 witnesses

B. Description of corner evidence found and/or method applied in restoring or reestablishing corner:

J-1
Aug. 10, 1999 Cheboygan County Remonumentation
Ronald Bischer #22428
found 1/2" rod and cap
replaced with 5/8" rod and cap
found 4 witnesses


C. Description of monument for corner and accessories established to perpetuate locating the position of the corner:

J-1
5/8" bar and cap #22428
N32°E 68.90' 18" Cedar
N16°W 32.93' 10" Ironwood
N82°E 6.44' 6" Elm
S19°W 21.65' 12" Maple

LIBER 011 PAGE 159

Vicky Pizzomati
CLERK/REGISTER
CHEBOYGAN COUNTY MICHIGAN
REGISTER OF DEEDS
MAR 03 2000
SECTION
Register of Deeds Stamp & File Number

	A	B	C	D	E	F	G	H	I	J	K	L
1												
2	6		5		4		3		2		1	
3												
4	7		8		9		10		11		12	
5												
6	18		17		16		15		14		13	
7												
8	19		20		21		22		23		24	
9												
10	30		29		28		27		26		25	
11												
12	31		32		33		34		35		36	
13												

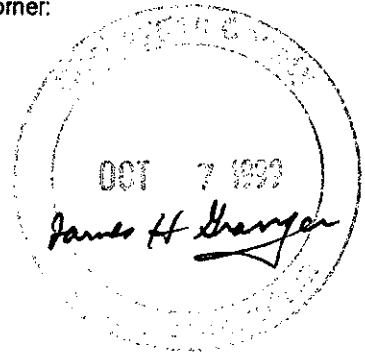

Signed by Ronald R. Bischer
Surveyor's Michigan License No. 22428

Date 12-18-99