

RECEIVED FOR RECORD

99 DEC 27 PM 3:46

1999 CHEBOYGAN COUNTY REMONUMENTATION

LAND CORNER RECORDATION CERTIFICATE
Filing Requirement of Act 74, Mich. P.A. 1970

Cheryl Popynski

CLERK/REGISTER
CHEBOYGAN COUNTY MICHIGAN

For corners in

Cheboygan
(County)

Located In: Corner Code #

- 1. Public Land Survey T 34N R 1E L-1
~~T 35N R 1E L-13a~~
- T R
- T R
- 2. Property Controlling S T R
- in Section S T R
- 3. Miscellaneous S T R
- Property in Sec. S T R

CHERRY &
REGISTERED

MAR 03 2000

SECTION
Register of Deeds Stamp & File Number

- 4. Lot No. _____, Recorded Plat _____
- 5. Private Claims _____

(Ronald Bischer, in a field survey on Aug. 10 1999 do hereby state that under requirements of P.A. 74, Michigan P.A. of 1970, the corner points mentioned in lines 1 and 2 above were in conformance with regulations and rules therefore as required in the current manual of survey instructions of the United States Department of the Interior, Bureau of Land Management or by a decree of a Court of Law and/or that the corner points mentioned in lines 3, 4 and 5 above were in conformance with the rules of the Michigan Board of Land Surveyors or by a Decree of a Court of Law; established, re-established, monumented, recovered, found as expressed below:

	A	B	C	D	E	F	G	H	I	J	K	L
1												
2	6		5		4		3		2		1	
3												
4	7		8		9		10		11		12	
5												
6	18		17		16		15		14		13	
7												
8	19		20		21		22		23		24	
9												
10	30		29		28		27		26		25	
11												
12	31		32		33		34		35		36	
13												

NOTE: Not more than 2 corners, all in the same town and range, may be recorded on this certificate.

A. Description of original monument and accessories and/or subsequent restoration:

L-1
1840 GLO Notes
N30°W 19 lks 8" Aspen
N21°E 8 lks 8" Aspen


June 25, 1976 Delmer Porter #15410
3/4" pipe
same witnesses as above

Sept. 6, 1974 Delmer Porter #15410
3/4" Pipe
N25°W 3.09' 8" Apple
N75°E 8.68' Fence cor.

B. Description of corner evidence found and/or method applied in restoring or reestablishing corner:

L-1

Aug 10, 1999 Cheboygan County Remonumentation
Ronald Bischer #22428
found 3/4" pipe replaced with 5/8" rod and cap
found 2 old witnesses and set 2 new ones

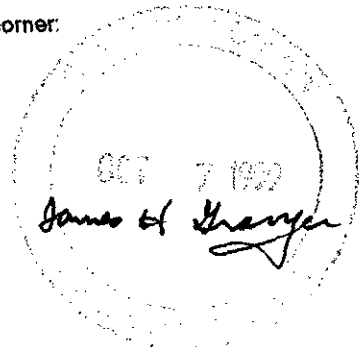


C. Description of monument for corner and accessories established to perpetuate locating the position of the corner:

L-1

5/8" rod and cap #22428
N75°E 8.68' Fence Corner
N25°W 3.09' 10" Apple
S82°E 38.25' 6" Spruce
S06°E 21.70' 7" Aspen

LIBER 011 PAGE 160

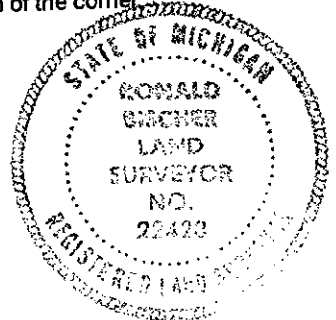

Signed by Ronald P. Bischer
Surveyor's Michigan License No. 22428

Date 12-18-99