

LAND CORNER RECORDATION CERTIFICATE
Filing Requirement of Act 74, Mich. P.A. 1970

For corners in

<u>Cheboygan</u> (County)	Located In:	Corner Code #
1. Public Land Survey	T 35N R 1E	C-10
	T 35N R 1E	C-11
2. Property Controlling in Section	S T R	
	S T R	
3. Miscellaneous Property in Sec.	S T R	
	S T R	

Register of Deeds Stamp & File Num

4. Lot No. _____, Recorded Plat _____

5. Private Claims _____

I, Carl T. Kiiskila, in a field survey on June 30, 19 98 do hereby state that under requirements of P.A. 74, Michigan P.A. of 1970, the corner points mentioned in lines 1 and 2 above were in conformance with regulations and rules therefore as required in the current manual of survey instructions of the United States Department of the Interior, Bureau of Land Management or by a decree of a Court of Law and /or that the corner points mentioned in lines 3, 4 and 5 above were in conformance with the rules of the Michigan Board of Land Surveyors or by a Decree of a Court of Law; established, re-established, monumented, recovered, found as expressed below:

A	B	C	D	E	F	G	H	I	J	K	L	M
1												
2	6		5		4		3		2		1	
3												
4	7		8		9		10		11		12	
5												
6	18		17		16		15		14		13	
7												
8	19		20		21		22		23		24	
9												
10	30	●	29		28		27		26		25	
11		●										
12	31		32		33		34		35		36	
13												

NOTE: Not more than 2 corners, all in the same town and range, may be recorded on this certificate.

A. Description of original monument and accessories and/or subsequent restoration:

C-10 GLO - George Cannon set section post 1855.
Wit: Hemlock 16" S 80° E 23 links
Yellow Birch 7" N 45° W 20 links

C-11 GLO - George Cannon set section post 1855.
Wit: Hemlock 12" N 25° E 29 links
Beech 10" S 63° W 37.5 links

B. Description of corner evidence found and/or method applied in restoring or reestablishing corner:

C-10 Found a broken concrete monument fitting Delmer E. Porter's (PS #15410) position and witnesses recorded in Liber 1, page 176 of Cheboygan County Register of Deeds.

C-11 Found a 1" pipe 18" below the road surface fitting Delmer E. Porter's (PS #15410) position and witnesses recorded in Liber 1, page 95 of Cheboygan County Register of Deeds.


C. Description of monument for corner and accessories established to perpetuate locating the position of the corner:

C-10 Found and removed broken concrete monument.
Set 1" x 32" iron pipe with cap and carsonite marker post.
Wit: Set nail in 8" Beech S 88° W 43.24'
Set nail in 4" Maple S 42° E 36.05'
Set nail in 4" Beech N 88° E 41.73'
Set nail in 3" Ironwood N 18° W 54.22'
Set nail in old stump N 31° W 28.7'
Carsonite post set West 25' ±

C-11 Found a 1" pipe 18" below road surface. Raised it with a 5/8" rerod and PS cap.
Wit: Power pole N 39° W 42.16'
Guy pole N 57° E 43.09'
Set nail in 14" White Birch S 21° E 95.34'
Set nail in 10" Maple S 33° W 101.64'
* Nail set in 12" White Birch S 37° W 88.5'
Set nail in 12" White Birch N 73° E 63.14'
Centerline of north-south road and road west West 1'

* (old witness by others)

Signed by Carl T. Kiiskila
Surveyor's Michigan License No. 33981

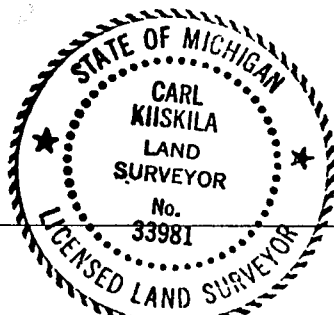

Date 7-28-99