

Surveyor
REMONUMENTATION

1993

COMMISSION

CHEBOYGAN COUNTY REMONUMENTATION CORNER
LAND CORNER RECORDATION CERTIFICATE
Filing Requirement of Act 74, Mich. P.A. 1970

For corners in
Cheboygan

(County)

Located In:

Corner Code ##

1. Public Land Survey	T	36N	R	1E	A-2
	T		R		
	T		R		
	T		R		
2. Property Controlling in Section	S		T	R	
	S		T	R	
3. Miscellaneous Property in Sec.	S		T	R	
	S		T	R	

RECEIVED
FOR RECORD
93 NOV 24 PM 4: 01

James H. Granger
CLERK/REGISTER
CHEBOYGAN COUNTY, MICHIGAN

Register of Deeds Stamp & File Number

4. Lot No. _____, Recorded Plat _____
5. Private Claims _____

	A	B	C	D	E	F	G	H	I	J	K	L	M
2	6		5		4		3		2		1		
3													
4	7		8		9		10		11		12		
5													
6	18		17		16		15		14		13		
7													
8	19		20		21		22		23		24		
9													
10	30		29		28		27		26		25		
11													
12	31		32		33		34		35		36		
13													

I, James H. Granger, in a field survey on November 1 - 12, 19 93, do hereby certify that under requirements of P.A. 74, Michigan P.A. of 1970, the corner points mentioned in lines 1 and 2 above were in conformance with regulations and rules therefore as required in the current manual of survey instructions of the United States Department of the Interior, Bureau of Land Management or by a decree of a Court of Law and/or that the corner points mentioned in lines 3, 4 and 5 above were in conformance with the rules of the Michigan Board of Land Surveyors or by a Decree of a Court of Law; established, re-established, monumented, re-monumented, recovered, found as expressed below:

NOTE: Not more than 4 corners, all in the same town and range, may be recorded on this certificate.


- A. Description of original monument and accessories and/or subsequent restoration:
1840 Original Survey John Hodgson
Set Wood Post
10" Aspen N 42° W 6 lks
9" Aspen S 8° E 14 lks
1901 Bill Bowen, Co. Surveyor
1946 Orlando Doyle #7319
1950 Orlando Doyle #7319
1984 Orlando Doyle #7319

- B. Description of corner evidence found and/or method applied in restoring or reestablishing corner:
Fd 1" ID pipe at intersection of road centerline and fence east
Found 2 witnesses with nail & tag #22428
Found 2 witnesses with nail & washer


Position accepted as most probable location of original monument set.

Marcus A. Ross

LIBER 010 PAGE 01

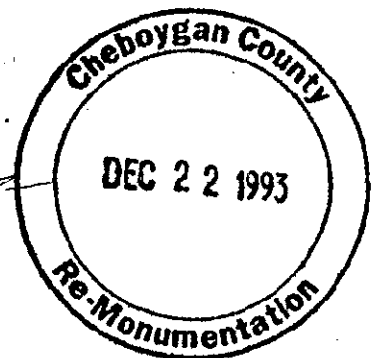

- C. Description of monument for corner and accessories established to perpetuate locating the position of the corner:
5/8" x 30" rod with 3" dia. alumin. cap
Fence post S 31° E 47.10' nail & tag #22428
4" Twin Pine S 56° E 25.66' old nail & washer
Fence post N 38° E 44.69' nail & tag #22428
3" Elm N 39° W 31.54' old nail & washer

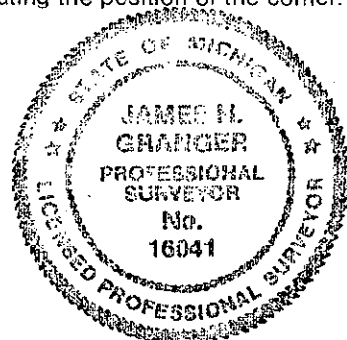

Signed by James H. Granger Date Nov. 24, 1993
Surveyor's Michigan License No. 16041