

SURVEY & REMONUMENTATION

1993

CHEBOYGAN COUNTY REMONUMENTATION CORNER
LAND CORNER RECORDATION CERTIFICATE
Filing Requirement of Act 74, Mich. P.A. 1970

COMMISSION

For corners in
Cheboygan

(County)

Located In:

Corner Code #/

1. Public Land Survey	T	36N	R	1E	A-3
	T		R		
	T		R		
	T		R		
2. Property Controlling in Section	S		T	R	
	S		T	R	
3. Miscellaneous Property in Sec.	S		T	R	
	S		T	R	

RECEIVED FOR RECORD

93 NOV 24 PM 4:09

James H. Granger
CLERK/REGISTER
CHEBOYGAN COUNTY, MICHIGAN

Register of Deeds Stamp & File Number

4. Lot No. _____, Recorded Plat _____
5. Private Claims _____

A	B	C	D	E	F	G	H	I	J	K	L	M
2	6		5		4		3		2		1	
3												
4	7		8		9		10		11		12	
5												
6	18		17		16		15		14		13	
7												
8	19		20		21		22		23		24	
9												
10	30		29		28		27		26		25	
11												
12	31		32		33		34		35		36	
13												

I, James H. Granger, in a field survey on November 1 - 12, 19 93, do hereby certify that under requirements of P.A. 74, Michigan P.A. of 1970, the corner points mentioned in lines 1 and 2 above were in conformance with regulations and rules therefore as required in the current manual of survey instructions of the United States Department of the Interior, Bureau of Land Management or by a decree of a Court of Law and/or that the corner points mentioned in lines 3, 4 and 5 above were in conformance with the rules of the Michigan Board of Land Surveyors or by a Decree of a Court of Law; established, re-established, monumented, re-monumented, recovered, found as expressed below:

NOTE: Not more than 4 corners, all in the same town and range, may be recorded on this certificate.


A. Description of original monument and accessories and/or subsequent restoration:
1840 Original Survey John Hodgson
Set Wood Post
10" Pine N 56° W 29 lks
7" Pine S 26° W 19 lks
1901 Bill Bowen, Co. Surveyor
1922 Bill Bowen, Co. Surveyor
1948 Orlando Doyle #7319

B. Description of corner evidence found and/or method applied in restoring or reestablishing corner:
Fd 3/4" pipe badly bent
Location fit with 2 of 3 witnesses in Liber A, page 449
Found witness with worn tag

Position accepted as most probable location of original monument set.


Maura Paul

LIBER 010 PAGE 02

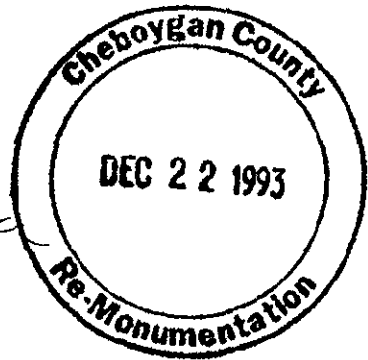

C. Description of monument for corner and accessories established to perpetuate locating the position of the corner:

5/8" x 30" rod with 3" dia. alumin. cap
8" Twin Apple S 16° W 22.49' old nail & tag
Guy Power pole N 27° W 39.05' old nail & tag
Power pole N 48° E 45.40' old nail & tag
Set nail & tag PS #16041 in:
4" Ash S 44° E 27.78'

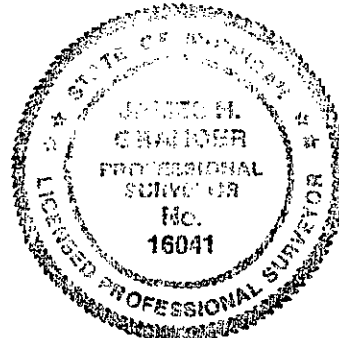

Signed by James H. Granger
Surveyor's Michigan License No. 16041

Date Nov. 24, 1993