

SURVEY & REMONUMENTATION

1993

COMMISSION

**CHEBOYGAN COUNTY REMONUMENTATION CORNER
LAND CORNER RECORDATION CERTIFICATE
Filing Requirement of Act 74, Mich. P.A. 1970**

For corners in

<u>Cheboygan</u> <small>(County)</small>	Located In:	Corner Code #
1. Public Land Survey	T <u>36N</u> R <u>1E</u>	<u>A-4</u>
	T _____ R _____	_____
	T _____ R _____	_____
	T _____ R _____	_____
2. Property Controlling in Section	S _____ T _____ R _____	_____
	S _____ T _____ R _____	_____
3. Miscellaneous Property in Sec.	S _____ T _____ R _____	_____
	S _____ T _____ R _____	_____
4. Lot No. _____, Recorded Plat _____		
5. Private Claims _____		

RECEIVED FOR RECORD
93 NOV 24 PM 4: 16
James Granger
CLERK/REGISTER
CHEBOYGAN COUNTY, MICHIGAN
Register of Deeds Stamp & File Number

I, James H. Granger, in a field survey on November 1 - 12, 1993, do hereby certify that under requirements of P.A. 74, Michigan P.A. of 1970, the corner points mentioned in lines 1 and 2 above were in conformance with regulations and rules therefore as required in the current manual of survey instructions of the United States Department of the Interior, Bureau of Land Management or by a decree of a Court of Law and/or that the corner points mentioned in lines 3, 4 and 5 above were in conformance with the rules of the Michigan Board of Land Surveyors or by a Decree of a Court of Law; established, re-established, monumented, re-monumented, recovered, found as expressed below:

A	B	C	D	E	F	G	H	I	J	K	L	M
2	6	5	4	3	2	1						
3												
4	7	8	9	10	11	12						
5												
6	18	17	16	15	14	13						
7												
8	19	20	21	22	23	24						
9												
10	30	29	28	27	26	25						
11												
12	31	32	33	34	35	36						
13												

NOTE: Not more than 4 corners, all in the same town and range, may be recorded on this certificate.

A. Description of original monument and accessories and/or subsequent restoration:

1840 Original Survey John Hodgson
Set Wood Post
6" Aspen S 31° E 11 lks


1922 Bill Bowen, Co. Surveyor
1952 Orlando Doyle #7319
1991 James H. Granger #16041

B. Description of corner evidence found and/or method applied in restoring or reestablishing corner:

Fd 1/2" pipe on S. edge of culvert
Found three 1991 witnesses

Position accepted as most probable location of original monument set.


Maurice A. Ross

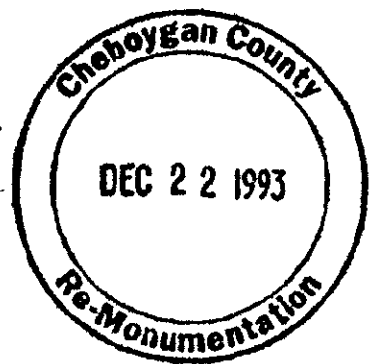

LIBER 010 PAGE 03

C. Description of monument for corner and accessories established to perpetuate locating the position of the corner:

5/8" x 30" rod with 3" dia. alumin. cap
Sign post S 1° W 10.55'
Set nail & tag PS #16041 in:
18" Spruce S 88° W 10.44'
4" Pine S 42° E 52.46'
6" Poplar N 42° E 70.48'

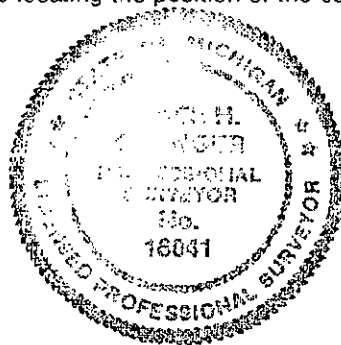

Signed by James H. Granger
Surveyor's Michigan License No. 16041

Date Nov. 24, 1993