

SURVEY &
REMONUMENTATION

James H. Granger
1993
COMMISSION

CHEBOYGAN COUNTY REMONUMENTATION CORNER
LAND CORNER RECORDATION CERTIFICATE
Filing Requirement of Act 74, Mich. P.A. 1970

For corners in
Cheboygan
(County)

Located In: Corner Code #/

1. Public Land Survey	T	<u>36N</u> R	<u>1E</u>	<u>A-5</u>
	T	_____	_____	_____
	T	_____	_____	_____
	T	_____	_____	_____
2. Property Controlling in Section	S	_____	_____	_____
	S	_____	_____	_____
3. Miscellaneous Property in Sec.	S	_____	_____	_____
	S	_____	_____	_____

RECEIVED
FOR RECORD
93 NOV 24 PM 4: 23
James H. Granger
CLERK/REGISTER
CHEBOYGAN COUNTY, MICHIGAN

Register of Deeds Stamp & File Number

4. Lot No. _____, Recorded Plat _____
5. Private Claims _____

	A	B	C	D	E	F	G	H	I	J	K	L	M
2	6	5	4	3	2	1							
3													
4	7	8	9	10	11	12							
5													
6	18	17	16	15	14	13							
7													
8	19	20	21	22	23	24							
9													
10	30	29	28	27	26	25							
11													
12	31	32	33	34	35	36							
13													


I, James H. Granger, in a field survey on November 1 - 12, 19 93, do hereby certify that under requirements of P.A. 74, Michigan P.A. of 1970, the corner points mentioned in lines 1 and 2 above were in conformance with regulations and rules therefore as required in the current manual of survey instructions of the United States Department of the Interior, Bureau of Land Management or by a decree of a Court of Law and/or that the corner points mentioned in lines 3, 4 and 5 above were in conformance with the rules of the Michigan Board of Land Surveyors or by a Decree of a Court of Law; established, re-established, monumented, re-monumented, recovered, found as expressed below:

NOTE: Not more than 4 corners, all in the same town and range, may be recorded on this certificate.

- A. Description of original monument and accessories and/or subsequent restoration:
1840 Original Survey John Hodgson
Set Wood Post
7" Spruce S 66° E 10 lks
9" Spruce N 42° W 20 lks
1911 Bill Bowen, Co. Surveyor
1922 Bill Bowen, Co. Surveyor


- B. Description of corner evidence found and/or method applied in restoring or reestablishing corner:
Fd 1" pipe in road
Found three witnesses without identification
Position accepted as most probable location of original monument set.

Maurice A. Ross

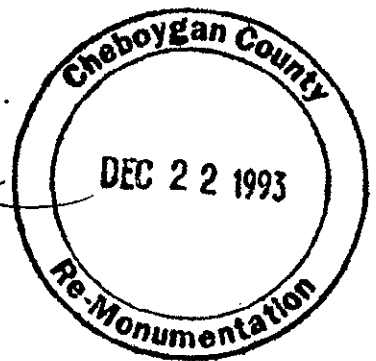

LIBER **010** PAGE **04**

- C. Description of monument for corner and accessories established to perpetuate locating the position of the corner:
5/8" x 30" rod with 3" dia. alumin. cap
8" Cedar N 51° W 40.35' Fd nail
6" Spruce S 66° W 24.48' Fd nail
6" Maple N 34° E 35.86' Fd PK nail
Set nail & tag PS #16041 in:
6" Spruce S 21° E 39.92'

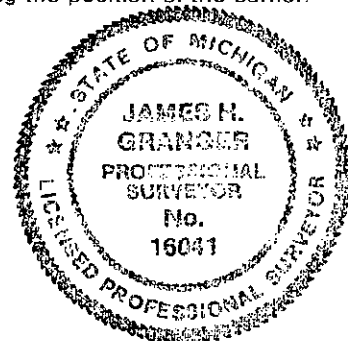

Signed by *James H. Granger*
Surveyor's Michigan License No. 16041

Date Nov. 24, 1993